


FED FROM DB 232/MAIN/C

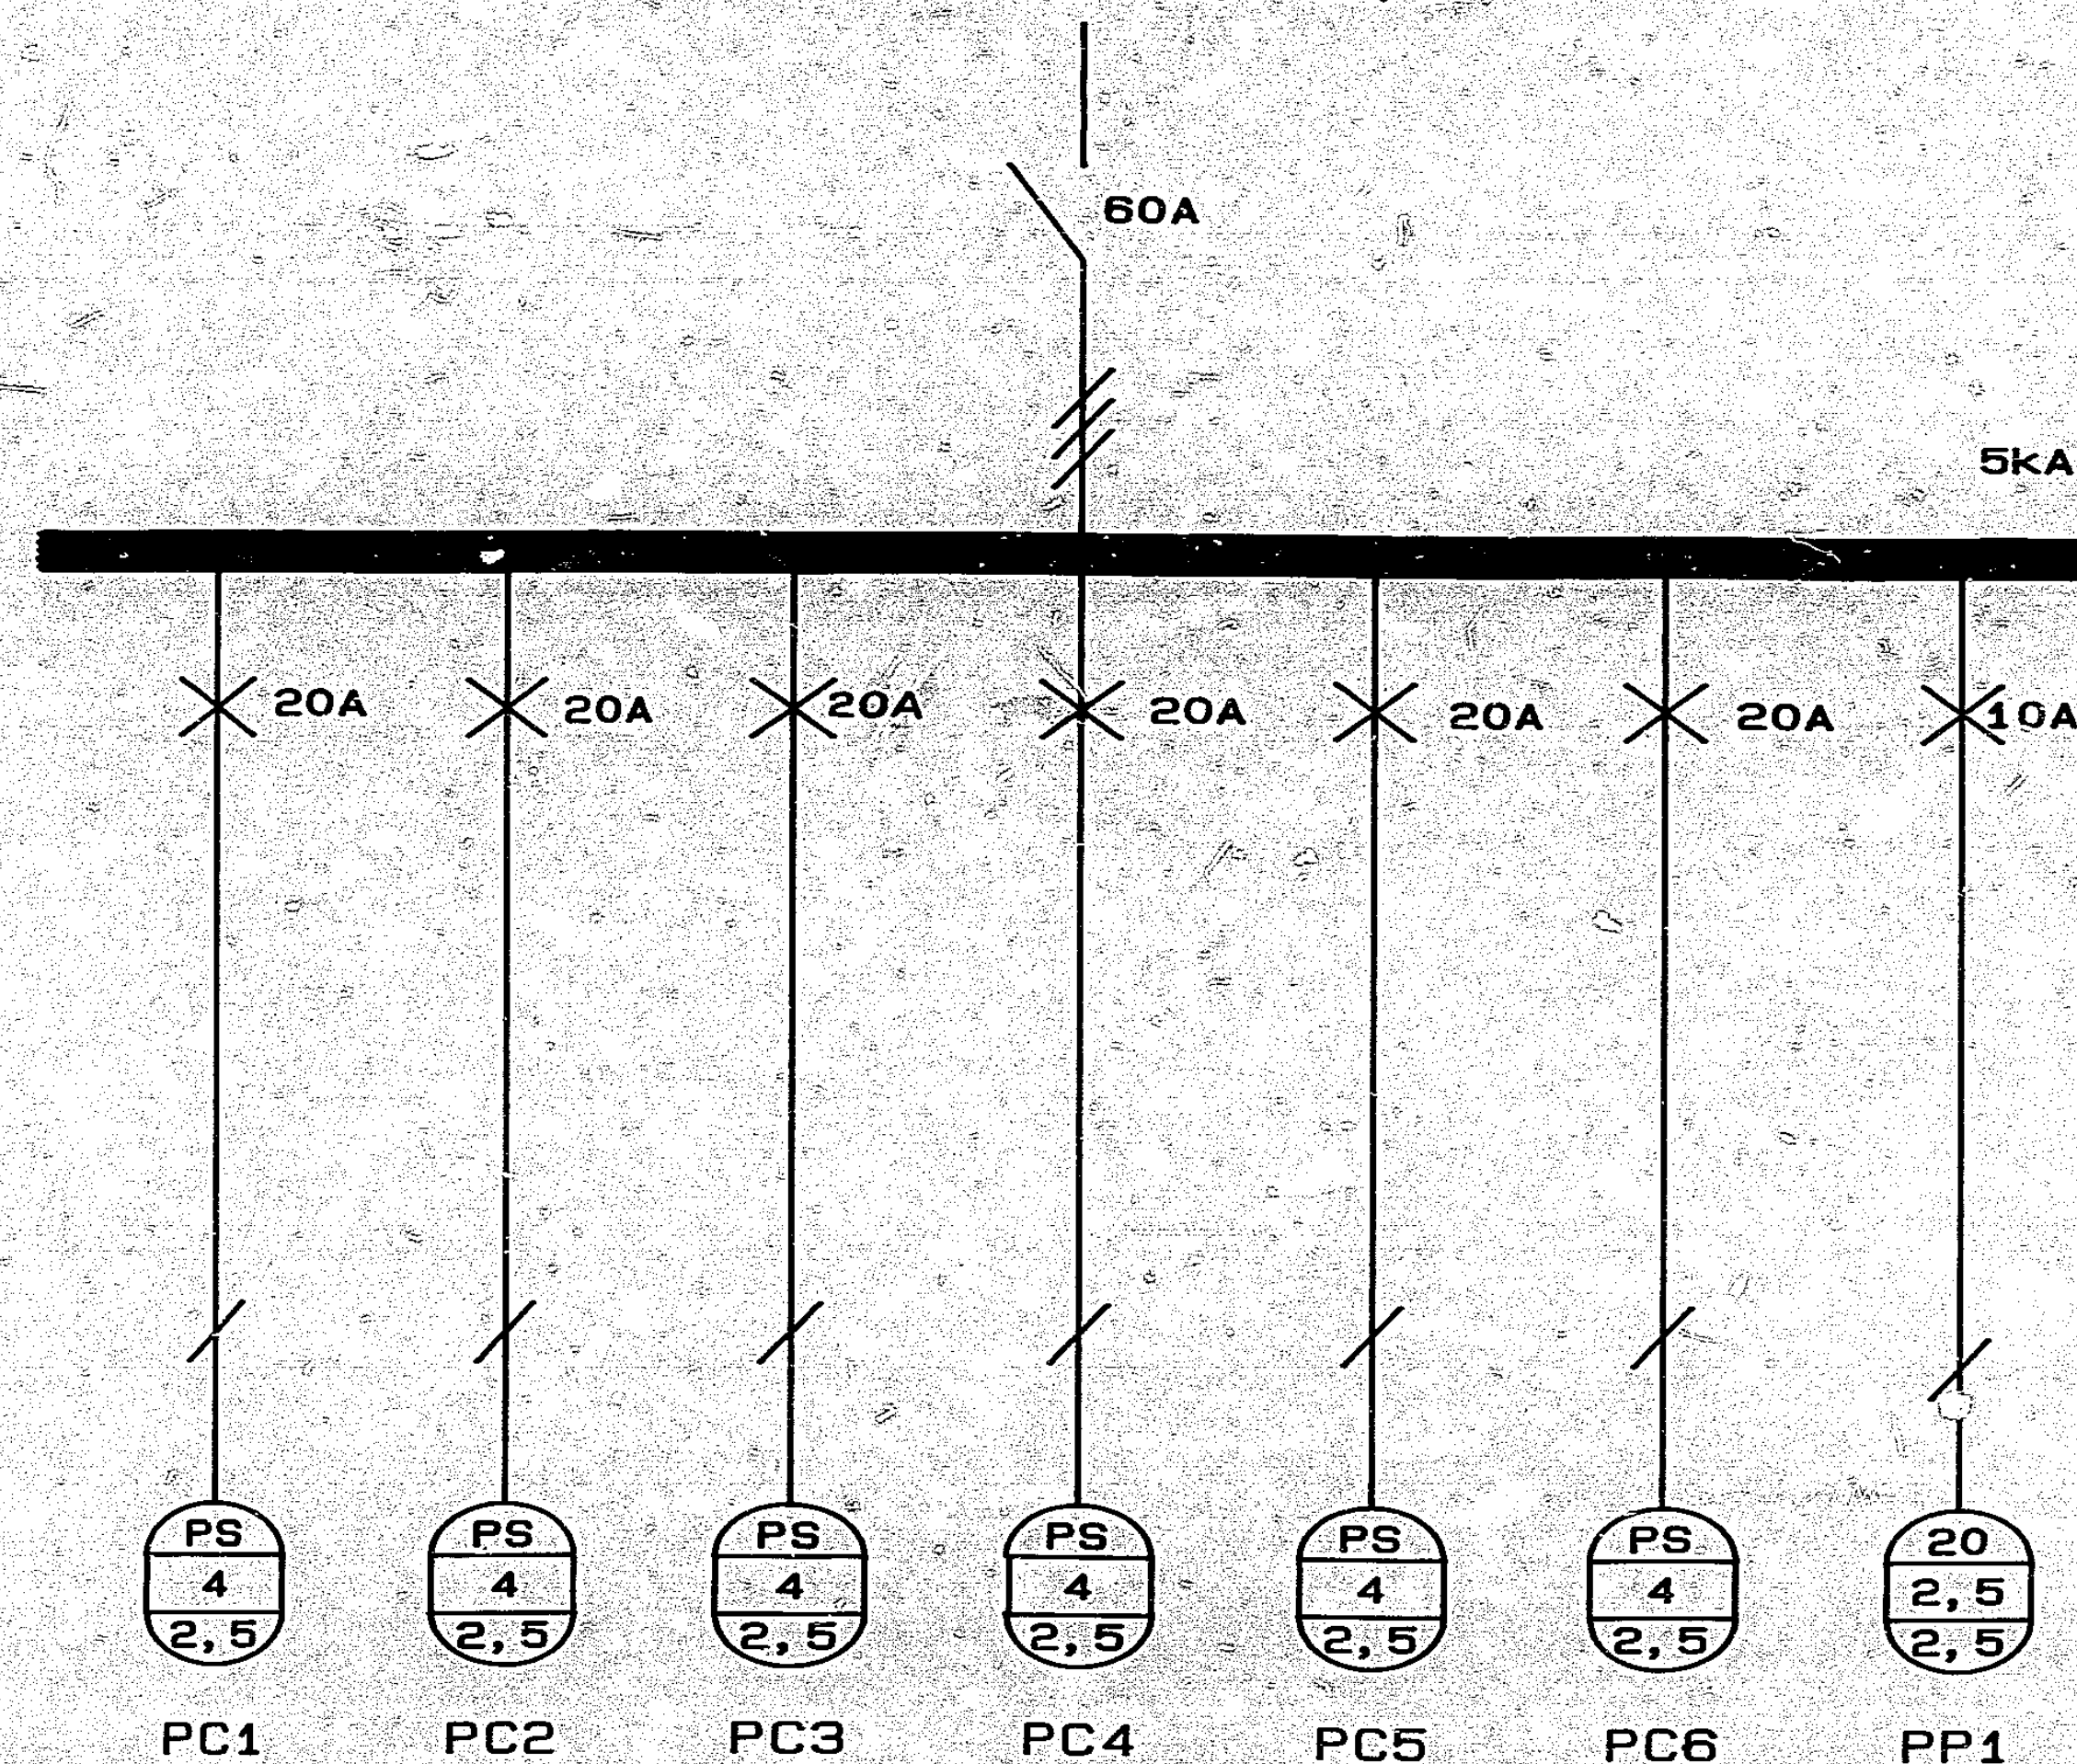

NOTES:

1. PS = POWERSKIRTING
2. THIS SECTION FORMS PART OF A THREE COMPARTMENT DB
3. ALL EARTH WIRES SHALL BE INSULATED


AS BUILT

DISTRIBUTION BOARD CONSTRUCTION

RECESSED	<input checked="" type="checkbox"/>	LOCKABLE DOORS	<input checked="" type="checkbox"/>	COLOUR - MAIN	ELECTRIC ORANGE	WIDTH	
HALF-RECESSED	<input type="checkbox"/>	SEPERATE DIVISIONS	<input checked="" type="checkbox"/>	COLOUR - EMERGENCY	RED	HEIGHT	
SURFACE	<input type="checkbox"/>	EMERGENCY SECTION	<input checked="" type="checkbox"/>	COLOUR - UPS	VERDIGRIS GREEN	DEPTH	
FLOOR-STANDING	<input type="checkbox"/>	UPS SECTION	<input checked="" type="checkbox"/>	COLOUR - NORMAL	ELECTRIC ORANGE		
DOORS	<input checked="" type="checkbox"/>	NORMAL SECTION	<input checked="" type="checkbox"/>	SPARE SPACE	30 %		

DISTRIBUTION BOARD ELECTRICAL SPECIFICATION

BUSBAR RATING	60A	FRONT ACCESS	<input checked="" type="checkbox"/>	CABLE ENTRY: TOP	
FAULT LEVEL	5KA	REAR ACCESS	<input type="checkbox"/>	CABLE ENTRY: BOTTOM	<input checked="" type="checkbox"/>
FULL NEUTRAL	<input checked="" type="checkbox"/>	SUPPLY: SINGLE CORE	<input type="checkbox"/>	FUTURE EXPANSION	
HALF - NEUTRAL	<input checked="" type="checkbox"/>	SUPPLY: CABLE	<input checked="" type="checkbox"/>	CABLE ENTRY: REAR	
EQUIPMENT	MERLIN GERIN	SUPPLY: BUSBAR	<input type="checkbox"/>	FUTURE EXPANSION	

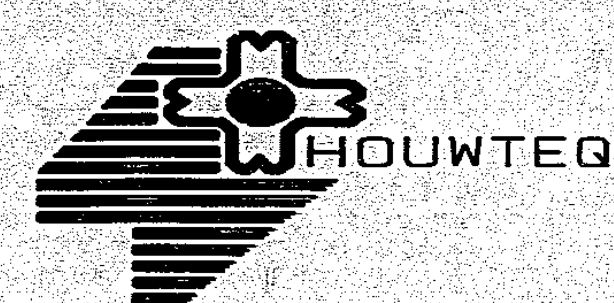REVISIONS	1	02/91	ADDED HALON PANEL FEED		BKS Inc./Ing		TITLE	
					CONS. NO. BKS-4771/232/ZE/047		SCHEMATIC - GROUND FLOOR	
					DESIGNED H. P. M. DRAWN H. B/CAD CHECKED H. P. M. DATE SEPT 1990		DB 232/G5/C (CLEAN)	
					DWS. NO. 671/000 2457		REV. Z	
	NO.	DATE	DESCRIPTION					