


- ELECTRICAL LEGEND
- DISTRIBUTION BOARD
 - FLUSH OR POWER SKIRTING MOUNTED 16A SSO (NORMAL)
 - FLUSH OR POWER SKIRTING MOUNTED 16A SSO (EMERGENCY)
 - FLUSH OR POWER SKIRTING MOUNTED 16A SSO (CLEAN-UPS)
 - SURFACE MOUNTED 16A SSO (NORMAL)
 - 4 COMPARTMENT TRUNKING IN CEILING VOID (LIGHTING, POWER, COMMUNICATIONS AND DATA)
 - SURFACE MOUNTED TRIPLE POLE ISOLATOR
 - FLUSH MOUNTED SPECIAL DRAWBOX
 - FLUSH MOUNTED SWITCHED MISO - 380V, 50HZ
 - FLUSH OR SURFACE MOUNTED POWERSKIRTING AS SPECIFIED (3 COMPARTMENTS)
 - SURFACE MOUNTED SWITCHED MISO - 380V, 50HZ
 - CRANE ISOLATOR AT HIGH LEVEL - FLUSH MOUNTED WITH OUTLET
 - HMC OUTLET POINT
 - FLUSH MOUNTED DOUBLE POLE ISOLATOR
 - SURFACE MOUNTED DOUBLE POLE ISOLATOR
 - PURPOSE MADE JUNCTION BOX WITH REMOVABLE LID

COPYRIGHT IS RESERVED ON THIS DRAWING

1	DATE	1/1/1990
2	BY	CONSTRUCTION DRAWING
3	DATE	1/1/1990
4	BY	SKETCH OFFICE - SSO OFFICE
5	DATE	
6	BY	
7	DATE	
8	BY	
9	DATE	
10	BY	
11	DATE	
12	BY	
13	DATE	
14	BY	
15	DATE	

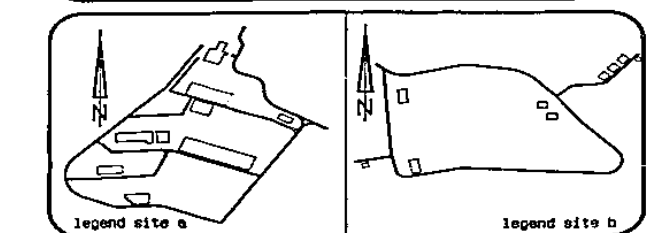

C. A. D.

DATE	DESCRIPTION	REVISION
1	1/1/1990	
2	1/1/1990	
3	1/1/1990	
CONSULTANTS

MR. J. H. VAN DER WERF CONSULTING ENGINEERS 0011 7405450	MR. J. H. VAN DER WERF CONSULTING ENGINEERS 0011 7405450
MR. J. H. VAN DER WERF CONSULTING ENGINEERS 0011 7405450	MR. J. H. VAN DER WERF CONSULTING ENGINEERS 0011 7405450

HAASVLAKTE


HAASVLAKTE

BUILDING 232
SITE A

GROUND FLOOR
POWER LAYOUT

AS BUILT

671/0002416

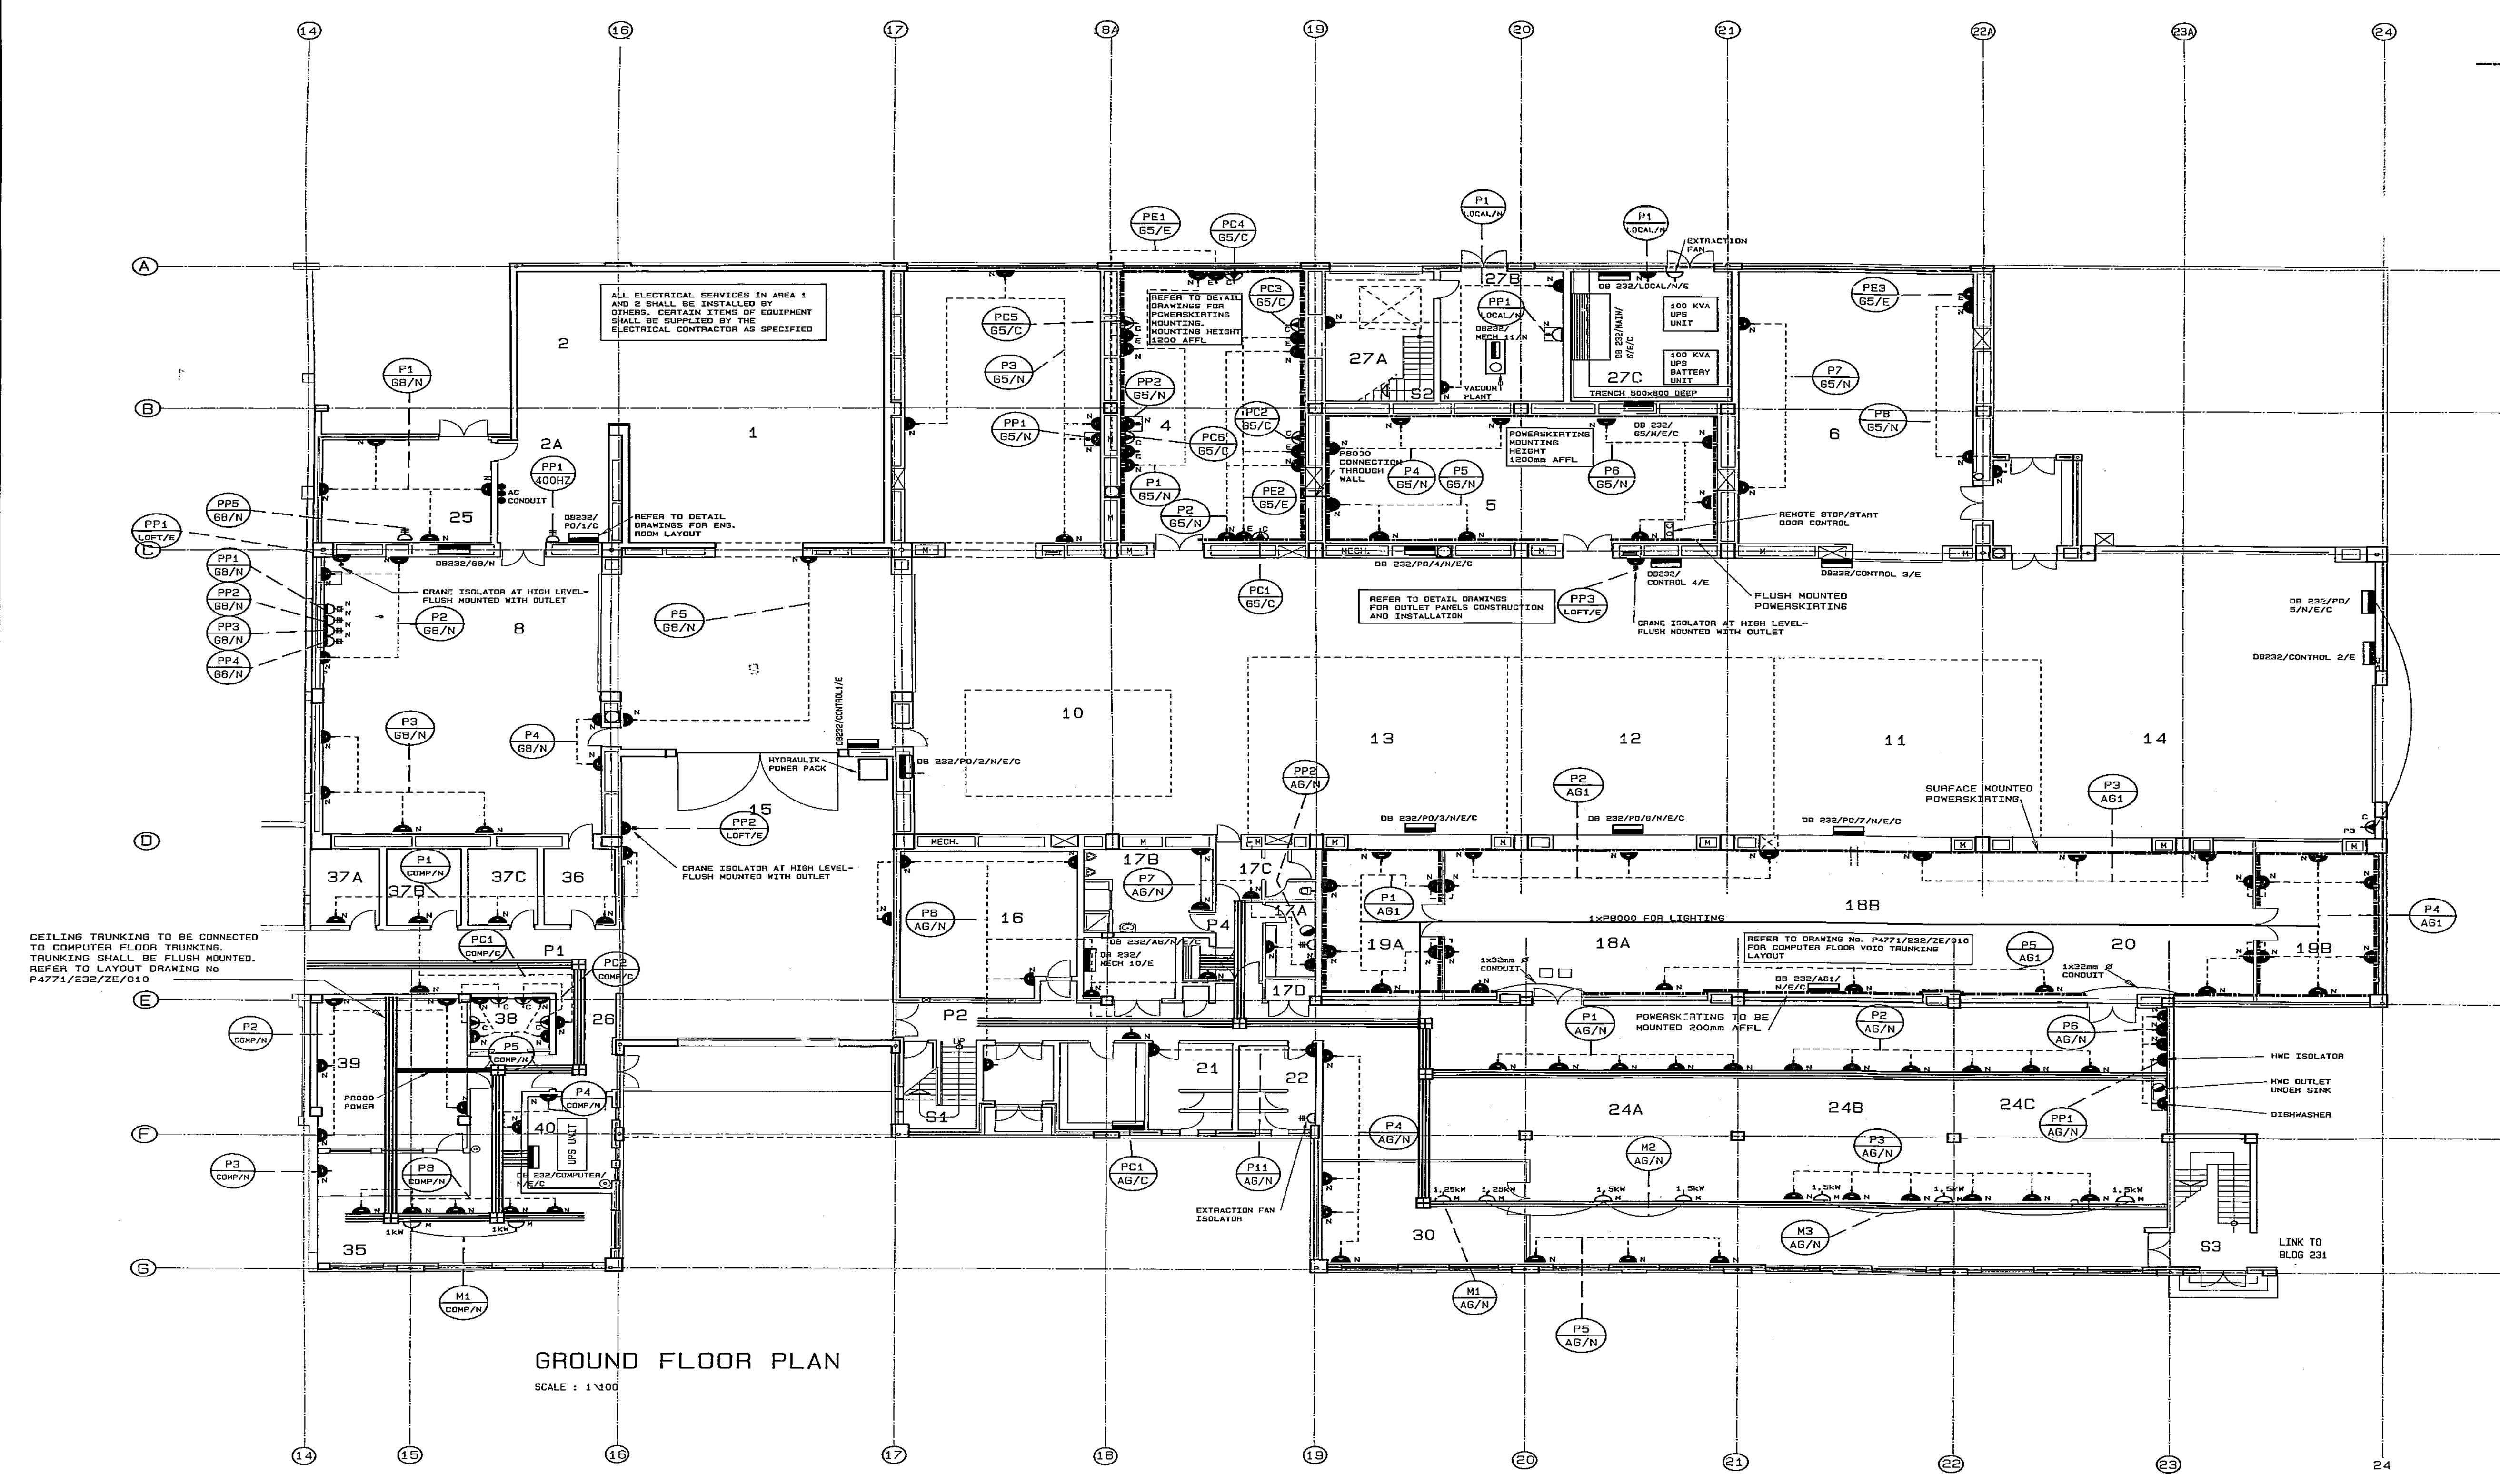

GROUND FLOOR PLAN
SCALE: 1:100

POWER
SECURITY
COMMUNICATIONS

3 COMPARTMENT POWERSKIRTING
SERVICES ALLOCATION

LIGHTING
SECURITY
COMMUNICATIONS
POWER

4 COMPARTMENT DUCTING SERVICES
ALLOCATION