


FED FROM DB 232/MAIN/E

160A
C161NI

5kA

NOTES:

- (1) PS = POWERSKIRTING
- (2) THIS SECTION FORMS PART OF A THREE COMPARTMENT DB.
- (3) REMOTE SWITCHING

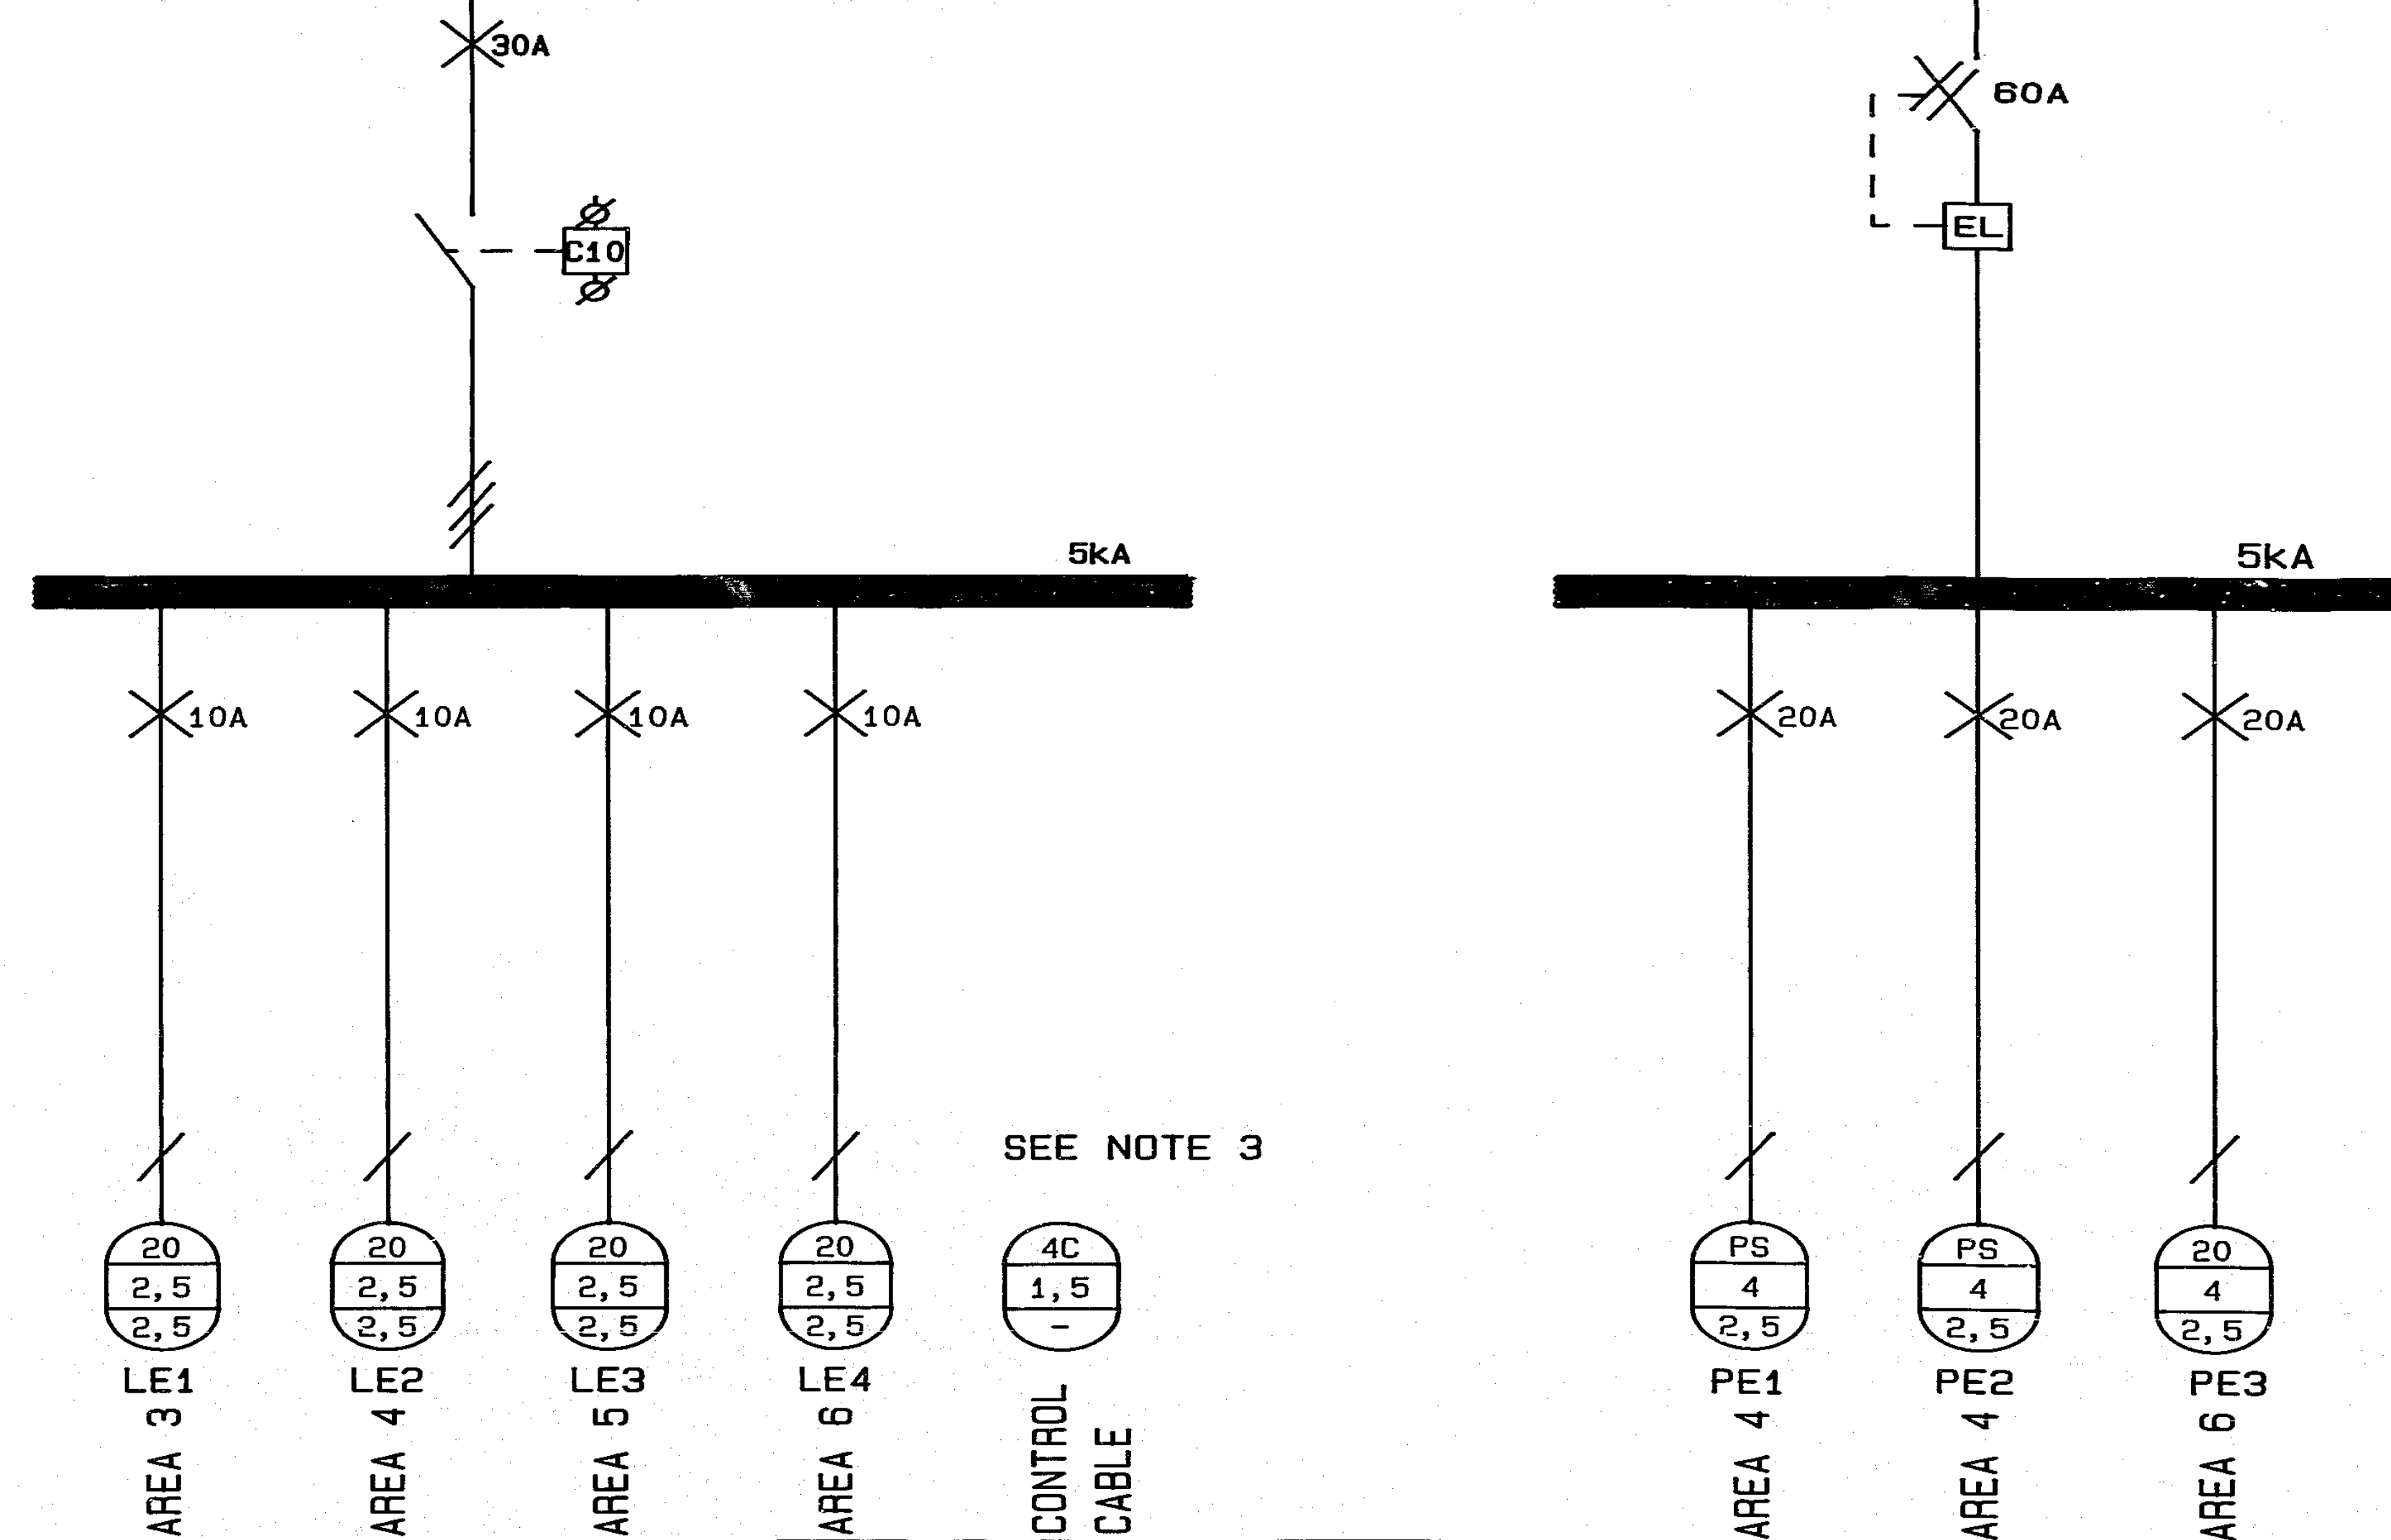

AS BUILT

DISTRIBUTION BOARD CONSTRUCTION

RECESSED	<input checked="" type="checkbox"/>	LOCKABLE DOORS	<input checked="" type="checkbox"/>	COLOUR - MAIN	ELECTRIC ORANGE	WIDTH	
HALF-RECESSED	<input type="checkbox"/>	SEPERATE DIVISIONS	<input checked="" type="checkbox"/>	COLOUR - EMERGENCY	RED	HEIGHT	
SURFACE	<input type="checkbox"/>	EMERGENCY SECTION	<input checked="" type="checkbox"/>	COLOUR - UPS	VERDIGRIS GREEN	DEPTH	
FLOOR-STANDING	<input type="checkbox"/>	UPS SECTION	<input checked="" type="checkbox"/>	COLOUR - NORMAL	ELECTRIC ORANGE		
DOORS	<input checked="" type="checkbox"/>	NORMAL SECTION	<input checked="" type="checkbox"/>	SPARE SPACE	E=50% C=11XTP		

DISTRIBUTION BOARD ELECTRICAL SPECIFICATION

BUSBAR RATING	160A	FRONT ACCESS	<input checked="" type="checkbox"/>	CABLE ENTRY: TOP	<input type="checkbox"/>
FAULT LEVEL	5kA	REAR ACCESS	<input type="checkbox"/>	CABLE ENTRY: BOTTOM	<input checked="" type="checkbox"/>
FULL NEUTRAL	<input checked="" type="checkbox"/>	SUPPLY: SINGLE CORE	<input type="checkbox"/>	FUTURE EXPANSION	<input type="checkbox"/>
HALF - NEUTRAL	<input type="checkbox"/>	SUPPLY: CABLE	<input checked="" type="checkbox"/>	CABLE ENTRY: REAR	<input type="checkbox"/>
EQUIPMENT	MERLIN GERIN	SUPPLY: BUSBAR	<input type="checkbox"/>	FUTURE EXPANSION	<input type="checkbox"/>

REVISIONS	NO.	DATE	DESCRIPTION
	1	03/91	DELETED REMOTE CONTROL CIRCUIT



BKS Inc./Ing			
CONS. NO.	REV.	SCALE	TITLE
BKS-4771/232/ZE/046	Z	N. T. S.	SCHEMATIC - GROUND FLOOR
DESIGNED	DRAWN	CHECKED	DATE
H. P. M.	H. B/CAD	H. P. M.	SEPT 1990

DWG. NO.	REV.
671/0002456	Z