


ELECTRICAL LEGEND

- ☐ SURFACE MOUNTED MONITORING OUTLET (COMMS)
(4x4 MONDER BOX)
- △ SURFACE MOUNTED TELEPHONE OUTLET (COMMS)
(4x4 MONDER BOX)
- 25mm Ø CONDUIT UNLESS OTHERWISE SPECIFIED

NOTES

COPYRIGHT IS RESERVED ON THIS DRAWING

REV.	DATE	BY	REASON
01			
02			
03			
04			
05			
06			
07			
08			
09			

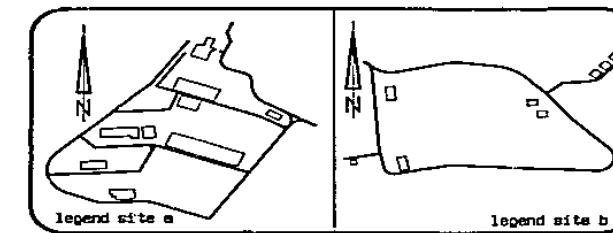

C. A. D.		DESC. NO.	FILE NAME
LAYER	DESCRIPTION	PLotted	
1	STRUCTURE		
2	FLOOR SLABS		
3	BEACONS		
4	DOORS & WINDOWS		
5	FURNITURE & FIXTURES		
6	MECH & ELECTRICAL		
7	ROOF & SECTION LINES		
8	CONCRETE		
9			
10	EXISTING BUILD		
11			
12			
13	REMARKS		
14	STANDARD		
15			
system	operator	date	revision

CONSULTANTS	
BOB ENGELING CONSULTING ENGINEERS (021) 5401670	JEFFREY VAN HEERDEN & PARTNERS INC. CONSULTING ENGINEERS (021) 7000000 (021) 8000000
HENDRIK VAN DER LEEUW THOMAS E. JONK ARCHITECTS (021) 5400000	VAN HEERDEN, KLEIN & EDWARDS CONSULTING ENGINEERS (021) 5400000



for construction	date	for building	date
BUILDING 232 SITE A			
SERVICE FLOOR SECURITY, COMMUNICATIONS AND DATA LAYOUT			
CONSULTANT NO. P4771	CONSULTANT NO. P4771/232/ZE/014	CONSULTANT NO. Z	
DRAWN HB/CAD	CHECKED HPM	DATE AUG 1990	SCALE 1:100
DRAWING NO. 671/0002424			Z

AS BUILT