


NOTES:

- (1) T = TRUNKING
- (2) THIS SECTION FORMS PART OF A THREE COMPARTMENT DB.

AS BUILT

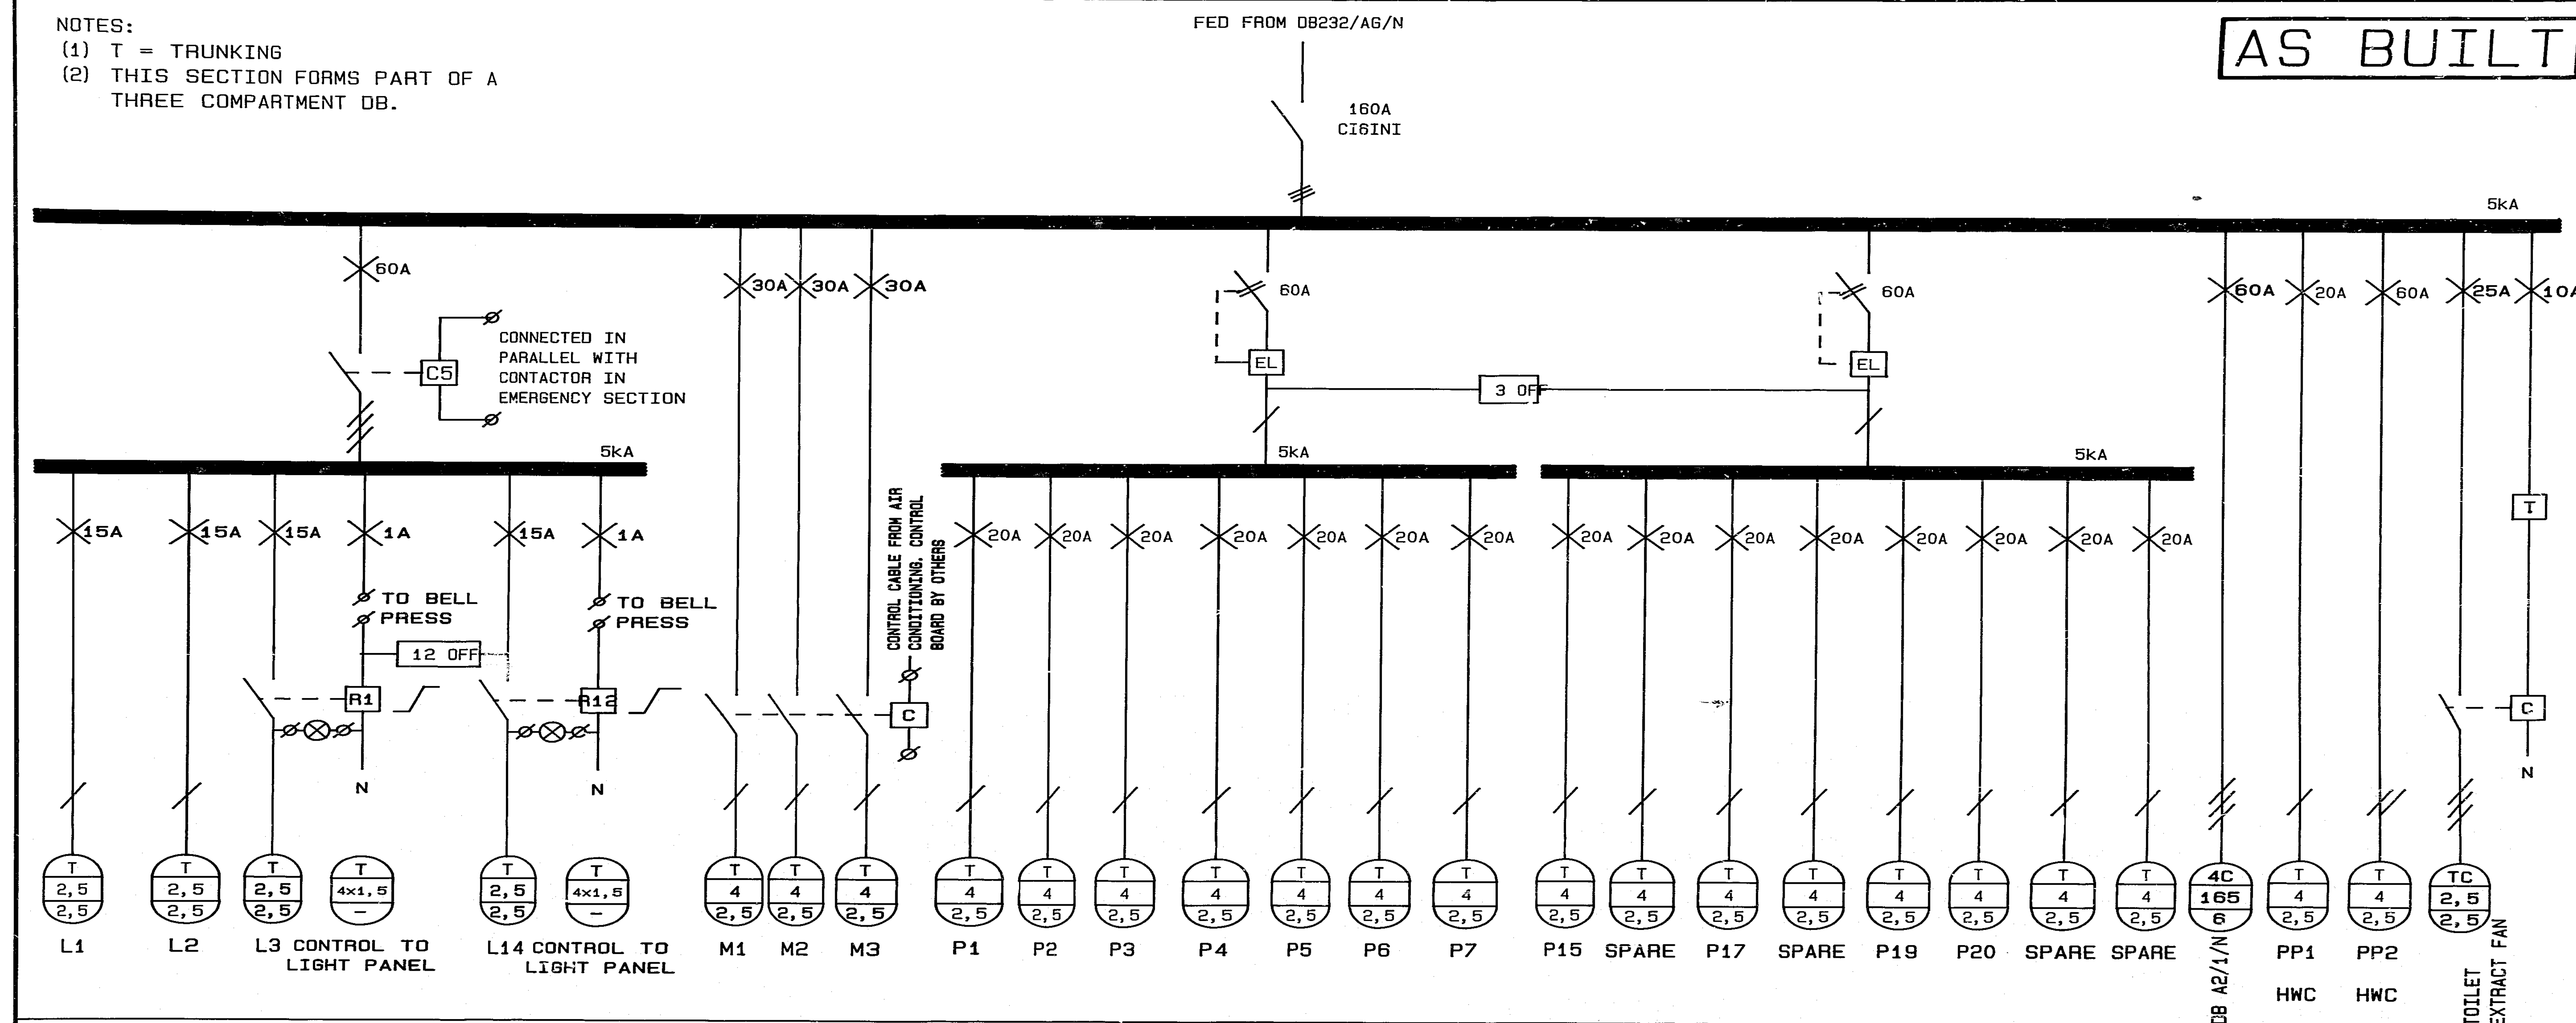

DISTRIBUTION BOARD CONSTRUCTION

RECESSED	LOCKABLE DOORS	COLOUR - MAIN	ELECTRIC ORANGE
HALF-RECESSED	SEPERATE DIVISIONS	COLOUR - EMERGENCY	RED
SURFACE	EMERGENCY SECTION	COLOUR - UPS	VERDIGRIS GREEN
FLOOR-STANDING	UPS SECTION	COLOUR - NORMAL	ELECTRIC ORANGE
DOORS	NORMAL SECTION	SPARE SPACE	30%

DISTRIBUTION BOARD ELECTRICAL SPECIFICATION

BUSBAR RATING	160A	FRONT ACCESS	CABLE ENTRY: TOP
FAULT LEVEL	5kA	REAR ACCESS	CABLE ENTRY: BOTTOM
FULL NEUTRAL		SUPPLY: SINGLE CORE	FUTURE EXPANSION
HALF - NEUTRAL		SUPPLY: CABLE	CABLE ENTRY: REAR
EQUIPMENT	MERLIN GERIN	SUPPLY: BUSBAR	FUTURE EXPANSION

NO.	DATE	DESCRIPTION
1	02/91	ADDED FEED TO MECH 9



BKS Inc./Ing	
CONS. NO.	BKS-4771/232/ZE/039
DESIGNED	H. P. M.
DRAWN	W. G/CAD
CHECKED	H. P. M.
DATE	SEPT 1990

TITLE	SCHEMATIC - SECOND FLOOR
	DB 232/A2/N (NORMAL)
DWG. NO.	671/0002449
REV.	Z