

- ELECTRICAL LEGEND**
- 20mm Ø CONDUIT UNLESS OTHERWISE SPECIFIED
 - IONIZATION TYPE SMOKE DETECTOR-TRUSS MOUNTED (50mm Ø ROUND BOX)
 - IONIZATION TYPE SMOKE DETECTOR-CEILING MOUNTED (50mm Ø ROUND BOX)
 - BREAK GLASS RELEASE (100x50x50 OUTLET BOX - HEIGHT: 1.4m AFFL)
 - BELL (100x50x50 OUTLET BOX)
 - REMOTE INDICATOR (100x50x50 OUTLET BOX - HEIGHT: 2.5m AFFL)
 - FLUSH MOUNTED DRAWBOX - 100x100x50mm
 - TWO OUTPUTS (4x4 BOX)


SECOND FLOOR PLAN
SCALE 1:100

REVISIONS

NO.	DATE	BY	REASON
01			
02			
03			
04			
05			
06			
07			
08			

COPYRIGHT IS RESERVED ON THIS DRAWING

NO.	DATE	BY	REASON
01			
02			
03			
04			
05			
06			
07			
08			

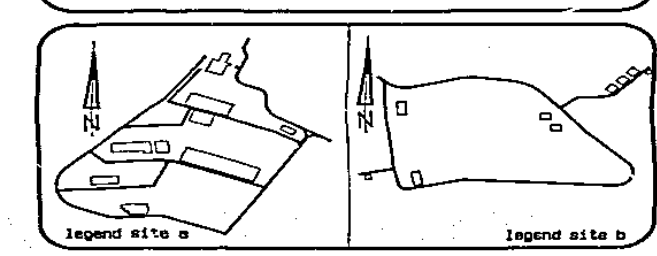

C.A.D. FILE NO. 810232P3

LAYER	DESCRIPTION	PLotted
1	STRUCTURE	
2	FLOOR SLAB	
3	WALLS	
4	DOORS & WINDOWS	
5	FITTINGS & FIXTURES	
6	MECHANICAL & ELECTRICAL	
7	TEXT & DIMENSION LINES	
8	SHADING	
9	SECTION LINES	
10	SECTION SHED	
11	GRID	
12	GRID	
13	GRID	
14	GRID	
15	GRID	

CONSULTANTS

NAME	COMPANY	ADDRESS	PHONE
JOHANNES VAN DER MERWE	ENGINEERING	10111 JORDANS (021) 880000	
JOHANNES VAN DER MERWE	ENGINEERING	10111 JORDANS (021) 880000	
JOHANNES VAN DER MERWE	ENGINEERING	10111 JORDANS (021) 880000	



FOR CONSULTANT DATE FOR DRAWING DATE

TITLE
BUILDING 232
SITE A

DRWG. TITLE
SECOND FLOOR
FIRE DETECTION LAYOUT

NO.	DATE	BY	REASON
01			
02			
03			
04			
05			
06			
07			
08			

AS BUILT

NO.	DATE	BY	REASON
01			
02			
03			
04			
05			
06			
07			
08			