



AS BUILT

FED FROM DB232/MAIN/E

NOTES:

- (1) T = TRUNKING
- (2) THIS SECTION FORMS PART OF A
THREE COMPARTMENT DB.
- (3) REMOTE SWITCHING

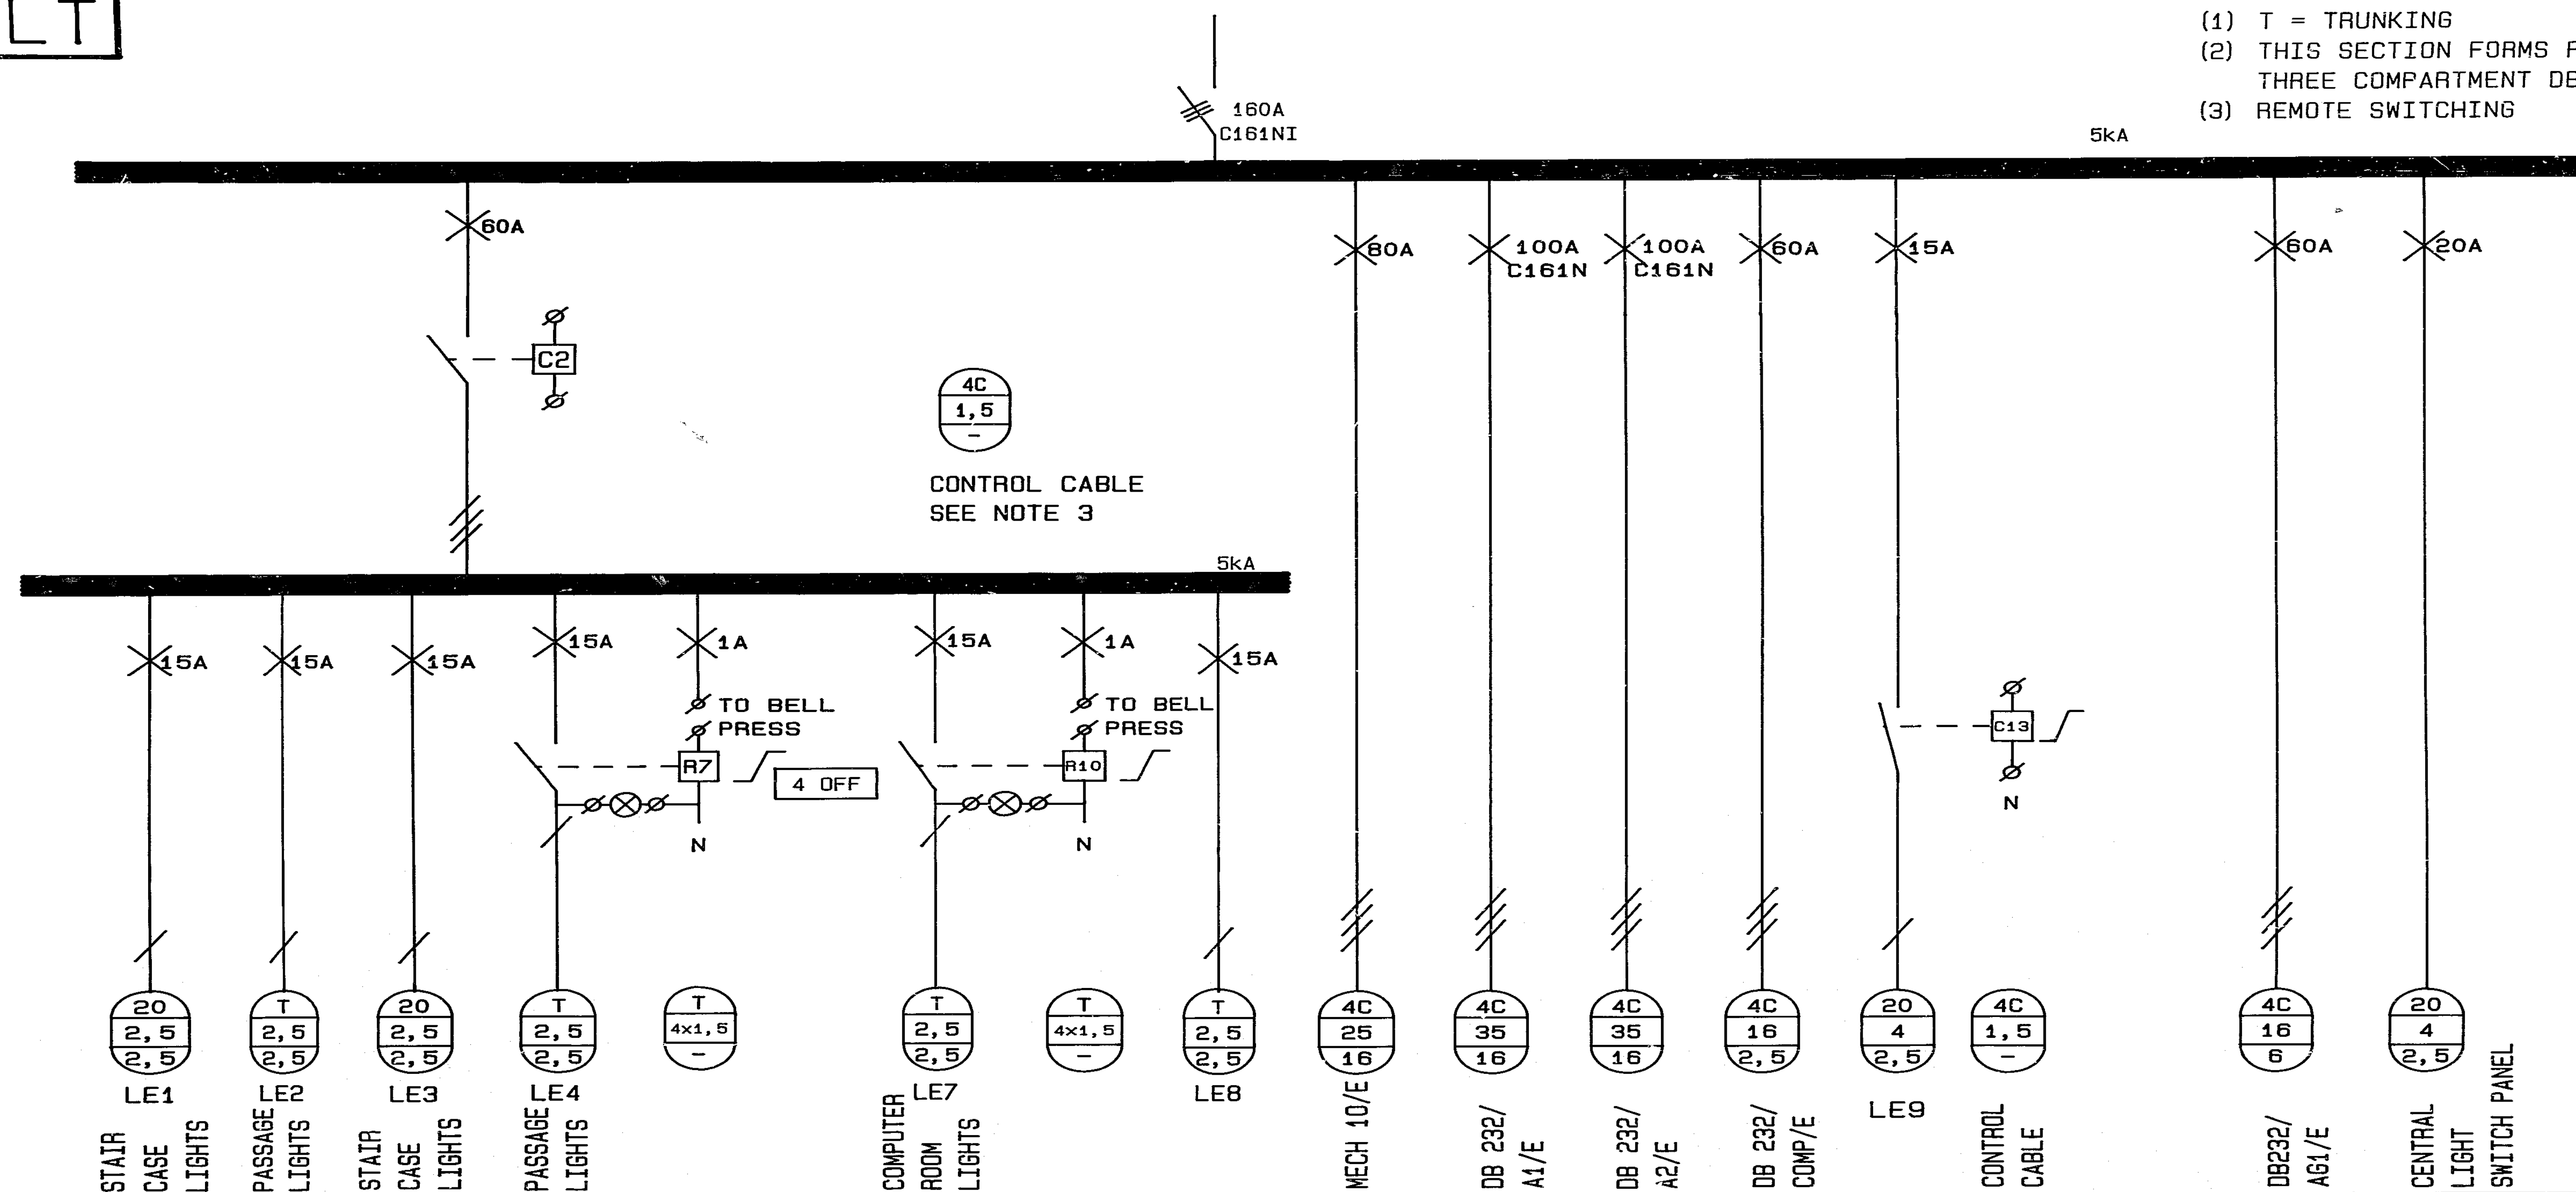

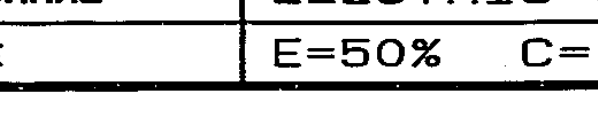DISTRIBUTION BOARD CONSTRUCTION										DISTRIBUTION BOARD ELECTRICAL SPECIFICATION									
RECESSED			LOCKABLE DOORS		COLOUR - MAIN	ELECTRIC ORANGE	WIDTH	---		BUSBAR RATING		160A	FRONT ACCESS		<input checked="" type="checkbox"/>	CABLE ENTRY: TOP		<input checked="" type="checkbox"/>	
HALF-RECESSED			SEPERATE DIVISIONS	<input checked="" type="checkbox"/>	COLOUR - EMERGENCY	RED	HEIGHT	---		FAULT LEVEL		5kA	REAR ACCESS		<input type="checkbox"/>	CABLE ENTRY: BOTTOM		<input checked="" type="checkbox"/>	
SURFACE		<input checked="" type="checkbox"/>	EMERGENCY SECTION	<input checked="" type="checkbox"/>	COLOUR - UPS	VERDIGRIS GREEN	DEPTH	---		FULL NEUTRAL		<input checked="" type="checkbox"/>	SUPPLY: SINGLE CORE		<input checked="" type="checkbox"/>	FUTURE EXPANSION		<input type="checkbox"/>	
FLOOR-STANDING		<input checked="" type="checkbox"/>	UPS SECTION	<input checked="" type="checkbox"/>	COLOUR - NORMAL	ELECTRIC ORANGE				HALF - NEUTRAL		<input checked="" type="checkbox"/>	SUPPLY: CABLE		<input checked="" type="checkbox"/>	CABLE ENTRY: REAR		<input type="checkbox"/>	
DOORS		<input checked="" type="checkbox"/>	NORMAL SECTION	<input checked="" type="checkbox"/>	SPARE SPACE	E=50% C=11XTP				EQUIPMENT		MERLIN GERIN	SUPPLY: BUSBAR		<input type="checkbox"/>	FUTURE EXPANSION		<input type="checkbox"/>	
REVISIONS	1	02/91	DELETED FEED TO MECH 7. CHANGED CABLE SIZE					BKS Inc./Ing				TITLE							
			TO MECH 10. ADDED CABLE AND MCB FEED TO AG1/E					CONS. NO.				SCHEMATIC - GROUND FLOOR							
	2	03/91	DELETED RELAY AND CONTROL MCB FOR REMOTE SWITCHING					BKS-4771/232/ZE/035				DB 232/AG/E (EMERGENCY)							
								REV. Z		SCALE N. T. S.									
								DESIGNED H. P. M.		DRAWN H. B/CAD		CHECKED H. P. M.		DATE SEPT 1990					
												DWS. NO. 671/0002445		REV. Z					
	NO.	DATE	DESCRIPTION																