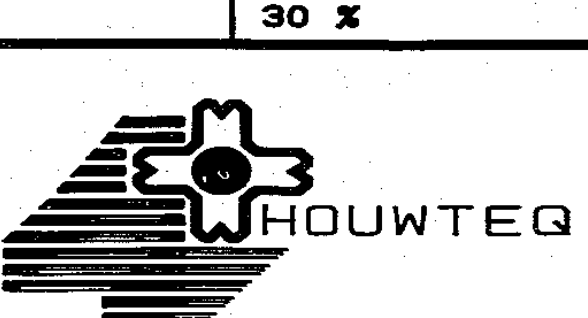


NOTES:
1. ALL EARTH WIRES
SHALL BE INSULATED

AS BUILT

DISTRIBUTION BOARD CONSTRUCTION						DISTRIBUTION BOARD ELECTRICAL SPECIFICATION							
RECESSED	<input checked="" type="checkbox"/>	LOCKABLE DOORS	<input checked="" type="checkbox"/>	COLOUR - MAIN	ELECTRICAL ORANGE	WIDTH		BUSBAR RATING	60A	FRONT ACCESS	<input checked="" type="checkbox"/>	CABLE ENTRY: TOP	
HALF-RECESSED	<input type="checkbox"/>	SEPERATE DIVISIONS	<input checked="" type="checkbox"/>	COLOUR - EMERGENCY	RED	HEIGHT		FAULT LEVEL	5KA	REAR ACCESS	<input type="checkbox"/>	CABLE ENTRY: BOTTOM	<input checked="" type="checkbox"/>
SURFACE	<input type="checkbox"/>	EMERGENCY SECTION	<input checked="" type="checkbox"/>	COLOUR - UPS	VERDIGRIS GREEN	DEPTH		FULL NEUTRAL	<input checked="" type="checkbox"/>	SUPPLY: SINGLE CORE	<input checked="" type="checkbox"/>	FUTURE EXPANSION	
FLOOR-STANDING	<input type="checkbox"/>	UPS SECTION	<input checked="" type="checkbox"/>	COLOUR - NORMAL	ELECTRICAL ORANGE			HALF - NEUTRAL	<input type="checkbox"/>	SUPPLY: CABLE	<input checked="" type="checkbox"/>	CABLE ENTRY: REAR	
DOORS	<input checked="" type="checkbox"/>	NORMAL SECTION	<input checked="" type="checkbox"/>	SPARE SPACE	30 %			EQUIPMENT	MERLIN GERIN	SUPPLY: BUSBAR	<input type="checkbox"/>	FUTURE EXPANSION	
REVISIONS						BKS Inc./Ing				TITLE			
						CONS. NO.		REV.	SCALE	SCHEMATIC - GROUND FLOOR			
						BKS-4771/232/ZE/053		Z	N. T. S.	DB 232/PO/2/3/6/7/N/E/C			
						DESIGNED		DRAWN	CHECKED	DATE	(NORMAL, EMERGENCY AND CLEAN)		
	NO.	DATE	DESCRIPTION			H. P. M.	H. B/CAD	H. P. M.	SEPT 1990	DWG. NO.		REV.	
										671/000 2463		Z	