

**ELECTRICAL LEGEND**

100 mm Ø PVC SLEEVE UNLESS OTHERWISE SPECIFIED


DISTRIBUTION BOARD

CONDUIT BY ELECTRICAL CONTRACTOR

1) SLEEVES TO BE PROVIDED AND INSTALLED BY OTHERS. THE ELECTRICAL CONTRACTOR SHALL BE RESPONSIBLE TO ENSURE THAT THE SLEEVES ARE INSTALLED IN THE CORRECT POSITIONS AND TO HIS SATISFACTION.

**COPYRIGHT IS RESERVED ON THIS DRAWING**

NO.	DATE	BY	REVISION
01	1989	HPM	CONSTRUCTION DRAWING, ADDITIONAL
02			CABLE TRAY
03			
04			
05			
06			
07			
08			
09			
10			

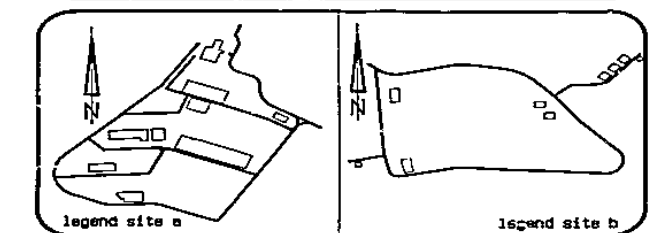

**C.A.D.**

NO.	DATE	BY	REVISION
01	1989	HPM	CONSTRUCTION DRAWING, ADDITIONAL
02			CABLE TRAY
03			
04			
**CONSULTANTS**

NO.	DATE	BY	REVISION
01	1989	HPM	CONSTRUCTION DRAWING, ADDITIONAL
02			CABLE TRAY
03			
04			
**BUILDING 232**

**SITE A**

**GROUND FLOOR SLEEVE AND CABLE TRAY LAYOUT**

NO.	DATE	BY	REVISION
01	1989	HPM	CONSTRUCTION DRAWING, ADDITIONAL
02			CABLE TRAY
03			
04			
AS BUILT 671/0002429 Z