


AS BUILT

FED FROM DB 232/MAIN/N

400A  
C401N1

- NOTES:  
1. T = TRUNKING  
2. THIS SECTION FORMS PART OF  
A THREE COMPARTMENT DB

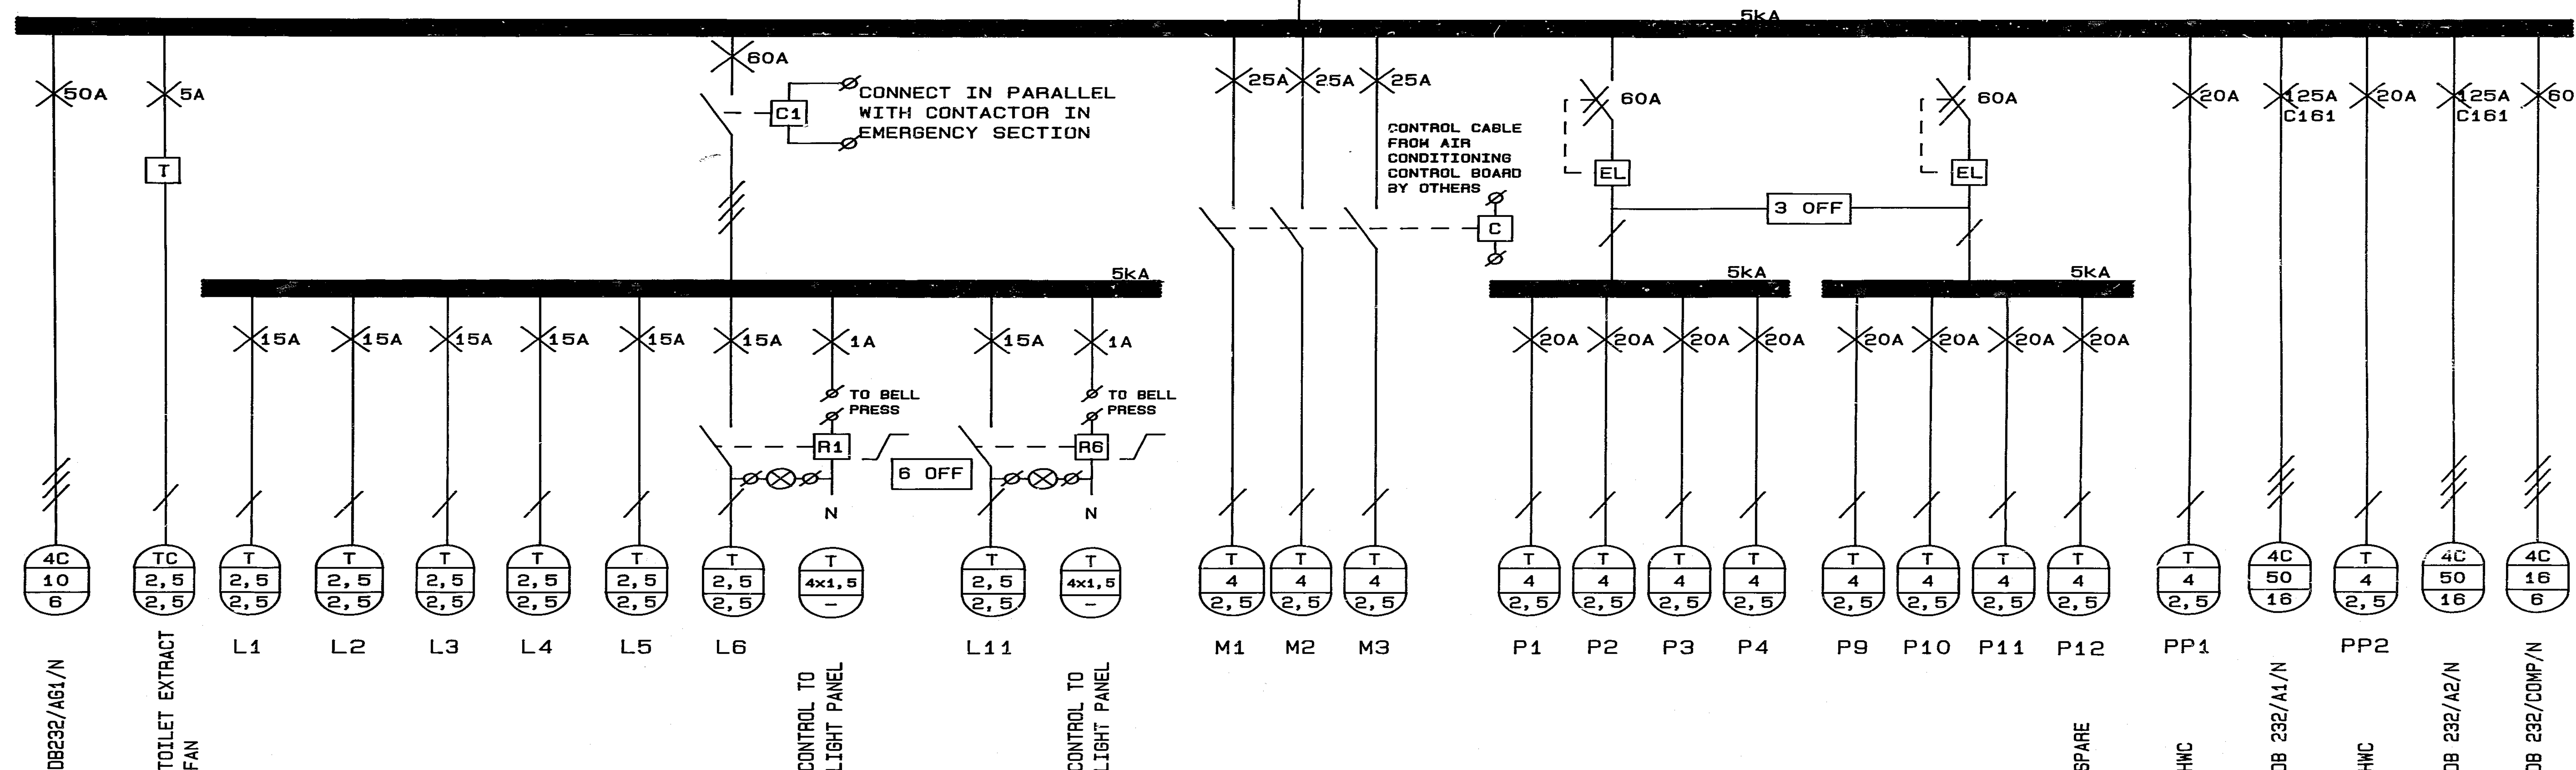

DISTRIBUTION BOARD CONSTRUCTION						DISTRIBUTION BOARD ELECTRICAL SPECIFICATION					
RECESSED		LOCKABLE DOORS		COLOUR - MAIN	ELECTRIC ORANGE	BUSBAR RATING	400A	FRONT ACCESS		CABLE ENTRY: TOP	
HALF-RECESSED		SEPERATE DIVISIONS		COLOUR - EMERGENCY	RED	FAULT LEVEL	5KA	REAR ACCESS		CABLE ENTRY: BOTTOM	
SURFACE		EMERGENCY SECTION		COLOUR - UPS	VERDIGRIS GREEN	FULL NEUTRAL		SUPPLY: SINGLE CORE		FUTURE EXPANSION	
FLOOR-STANDING		UPS SECTION		COLOUR - NORMAL	ELECTRIC ORANGE	HALF - NEUTRAL		SUPPLY: CABLE		CABLE ENTRY: REAR	
DOORS		NORMAL SECTION		SPARE SPACE	30 %	EQUIPMENT	MERLIN GERIN	SUPPLY: BUSBAR		FUTURE EXPANSION	

REVISIONS	1	02/91	DELETED 9x20A MCB. ADDED FEED TO MECH 7 AND AG1/N
	NO.	DATE	DESCRIPTION

BKS Inc./Ing				TITLE			
CONS. NO.	BKS-4771/232/ZE/034			REV.	Z		
DESIGNED	H. P. M.	DRAWN	H. B/CAD	SCALE	N. T. S.		
CHECKED	H. P. M.	DATE	SEPT 1990	DWG. NO.	671/000 2444		
				REV.	Z		