


- ELECTRICAL LEGEND**
- POWER SKIRTING FLUSH OR SURFACE MOUNTED AS SPECIFIED (3 COMPARTMENT)
 - TWO COMPARTMENT TRUNKING MOUNTED UNDER COMPUTER FLOOR (EMERGENCY AND CLEAN POWER)
 - FLUSH OR POWER SKIRTING MOUNTED 16A SSO (CLEAN-UPS)
 - FLUSH OR POWER SKIRTING MOUNTED 16A SSO (EMERGENCY)
 - FLUSH OR POWER SKIRTING MOUNTED 16A SSO (NORMAL)
 - SURFACE SWITCHED WSSD - 200V , 50 HZ. (CLEAN)

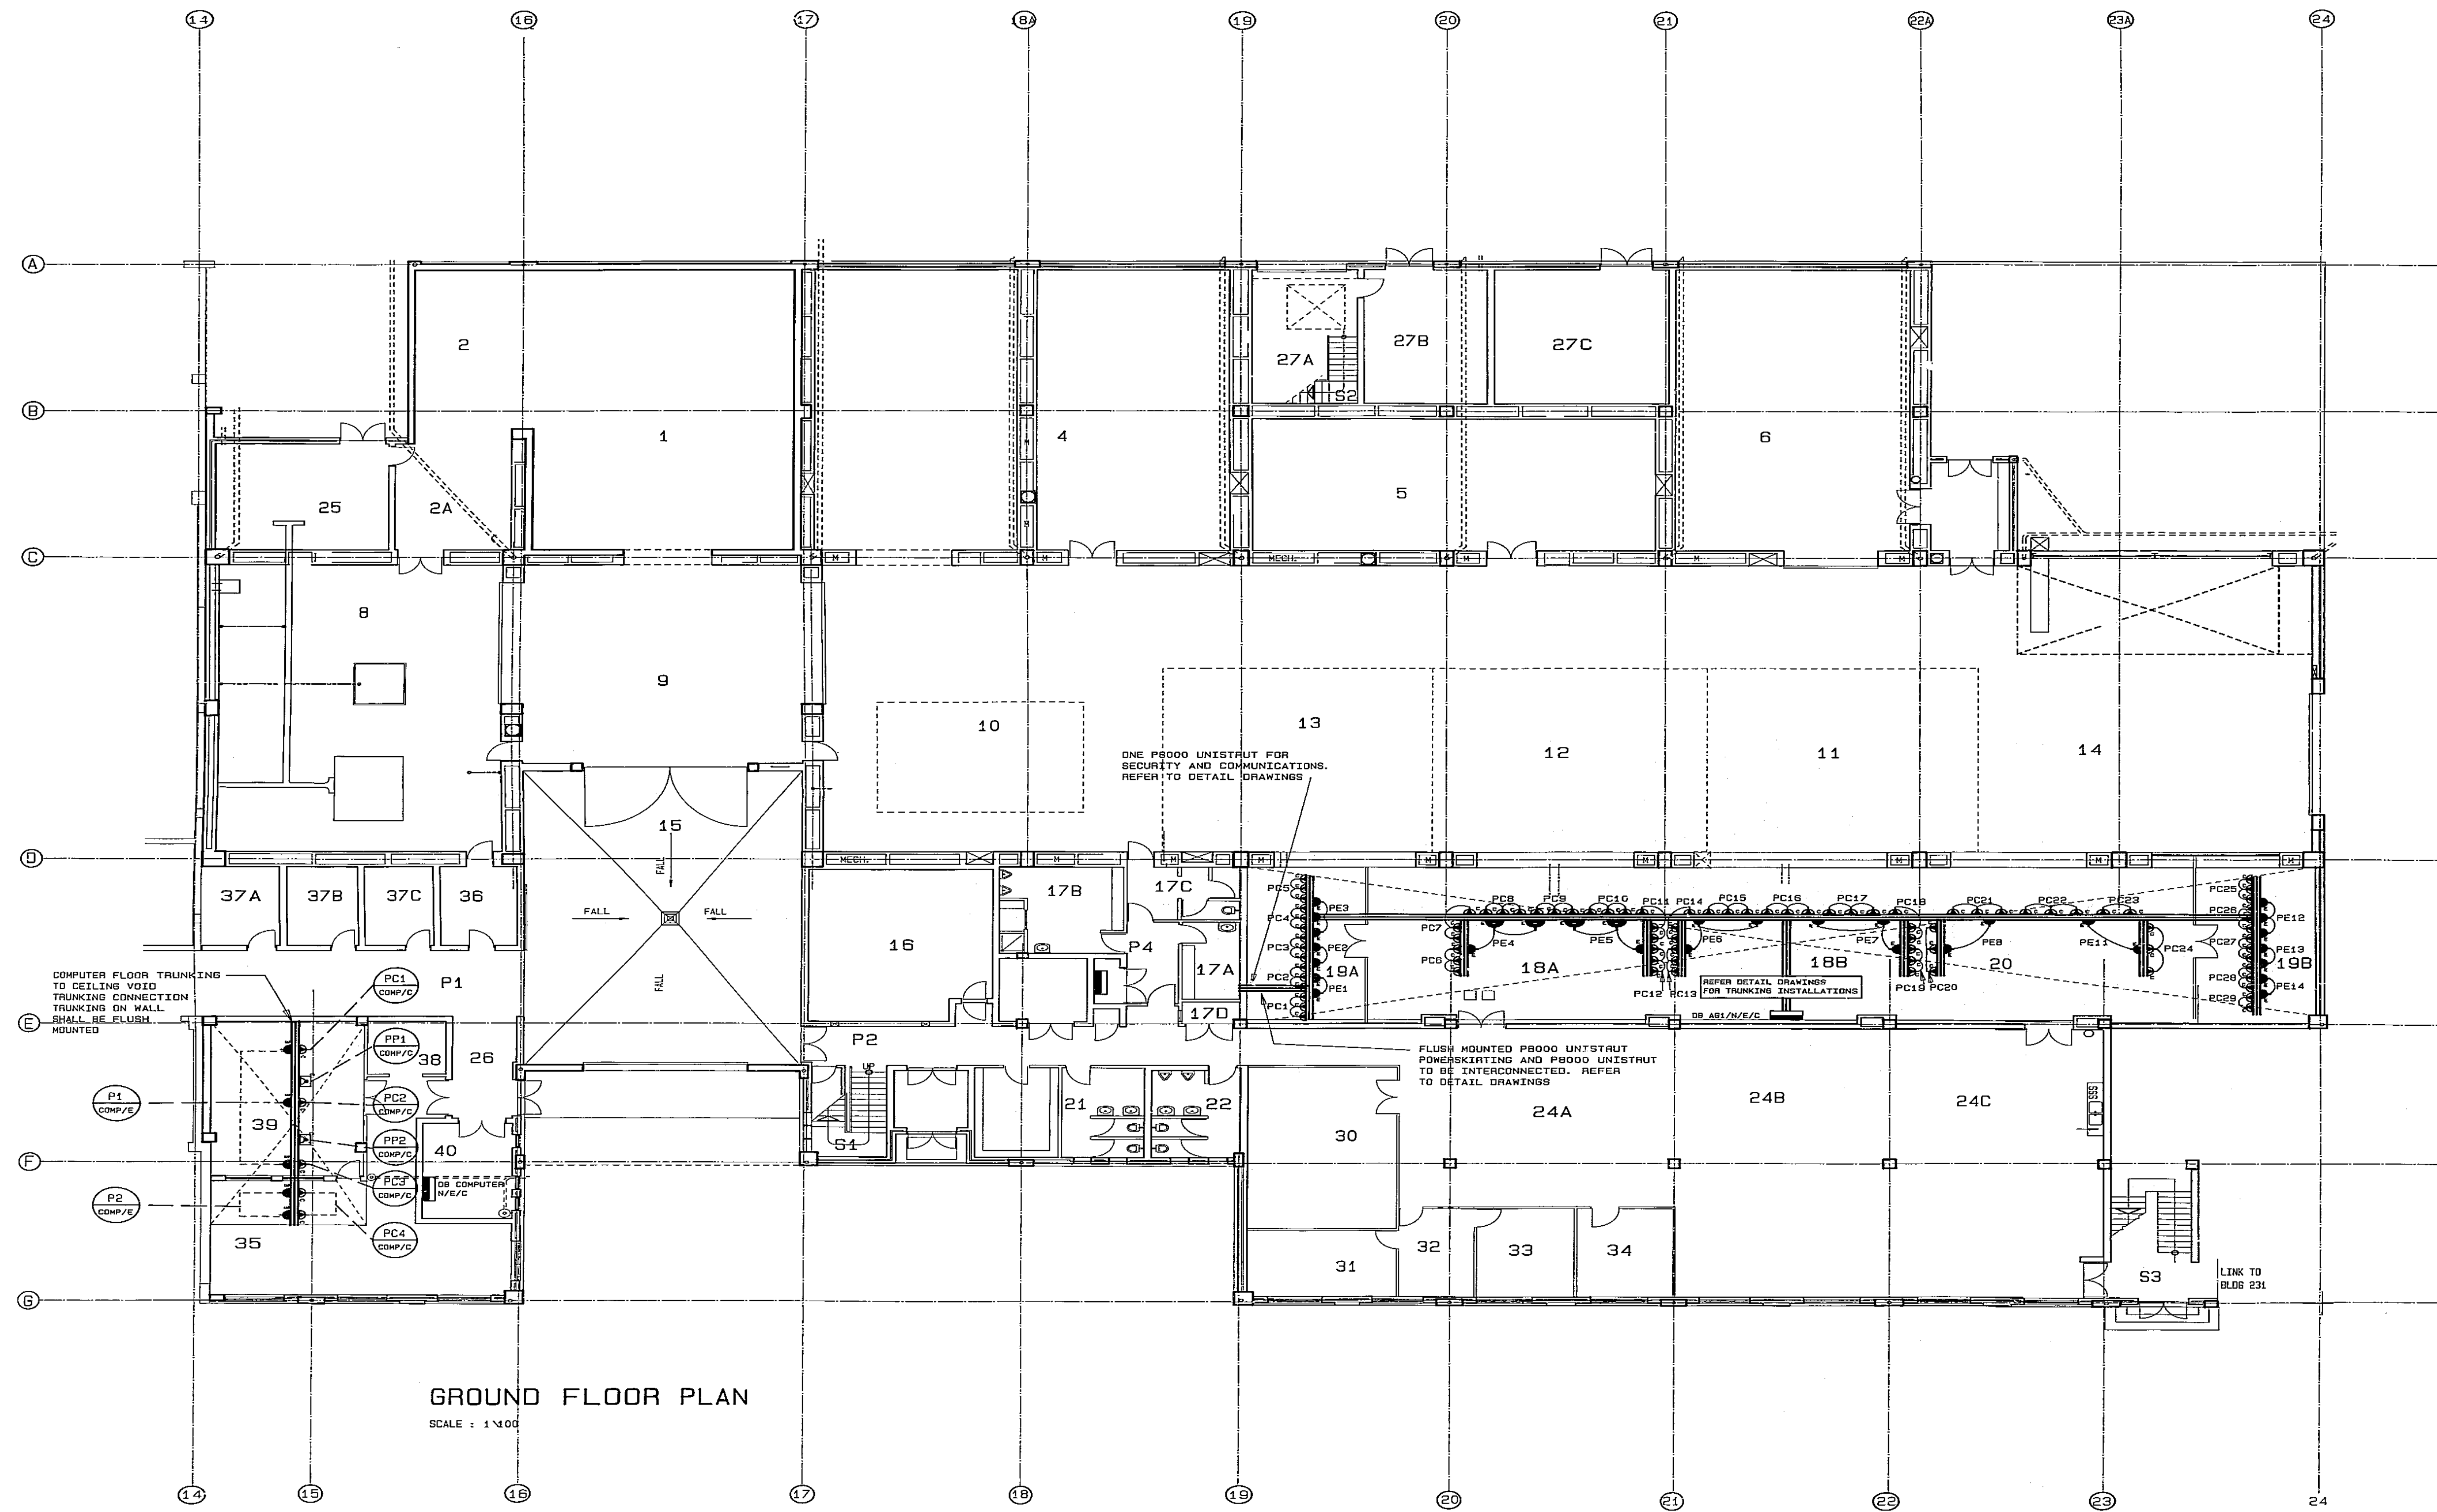


GROUND FLOOR PLAN
SCALE : 1:100

NOTES

NO.	DATE	BY	MULT.
01	05/91	HPK	ASBTD SD-SERVICE - CONSTRUCTION DRAWINGS
02			
03			
04			
05			
06			
07			
08			
09			
10			

COPYRIGHT IS RESERVED ON THIS DRAWING

NO.	DATE	BY	MULT.
01	05/91	HPK	ASBTD SD-SERVICE - CONSTRUCTION DRAWINGS
02			
03			
04			
05			
06			
07			
08			
09			
10			

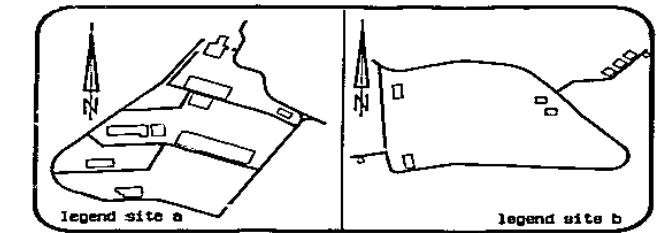

C. A. D

LAYER	DESCRIPTION	PLotted
1	LINEWORK	
2	FLUSH SKIRTING	
3	TRUNKING	
4	EMERGENCY	
5	CLEAN & WOODING	
6	FITTINGS & FITTINGS	
7	GROUP & RELATED TEST	
8	TEXT & SECTION LINES	
9	CONNECTIONS	
10	DETAILS, ETC.	
11		
12		
13		
14		
15		

CONSULTANTS

MR. DR. LUC CONSULTING ENGINEERS 0011 8461070	JEFFREY VAN NIEKERK & PARTNERS INC. CONSULTING ENGINEERS 0011 7704241 0011 8461070
MR. DR. LUC CONSULTING ENGINEERS 0011 8461070	JEFFREY VAN NIEKERK & PARTNERS INC. CONSULTING ENGINEERS 0011 7704241 0011 8461070

HAASVLAKTE

for consultant date for invoice date

11111

BUILDING 232
SITE A

01/01/1991

GROUND FLOOR COMPUTER ROOMS POWER LAYOUT

DATE/PROJECT NO.	DATE/PROJECT NO.	DATE/PROJECT NO.
P4771	P4771/232/ZE/010	Z
HW/CAD	H. P. H.	AUG 1990
1:100		
671/0002420		Z

CLEAN UPS POWER
EMERGENCY POWER
2 COMPARTMENT VOID DUCT
SERVICE ALLOCATION

AS BUILT