


ELECTRICAL LEGEND

- 4 COMPARTMENT TRUNKING (LIGHTING, POWER, COMMUNICATIONS AND DATA)
- FLUSH MOUNTED TELEPHONE OUTLET (COMMS) (4x4 BOX)
- SURFACE MOUNTED TELEPHONE OUTLET (COMMS) (4x4 WINDER BOX)
- FLUSH MOUNTED CARD READER OUTLET (SEC) (4x4 BOX)
- MOTION DETECTOR OUTLET (SEC) (50mm Ø ROUND BOX)
- THREE OR FOUR WAY CROSSOVER AS PER DETAIL DRAWINGS

NOTES
1. 90° FOUR COMPARTMENT DUCTING BENDS TO BE RADIUSSED

COPYRIGHT IS RESERVED ON THIS DRAWING

REV.	DATE	BY	REASON
01	04/01/99	HPH	CONSTRUCTION DRAWING
02	04/01/99	HPH	ADDED PROOF INTERLINKS, LIMITED
03			CHANGED DRAWING IN ROOM 204
04			
05			
06			
07			
08			

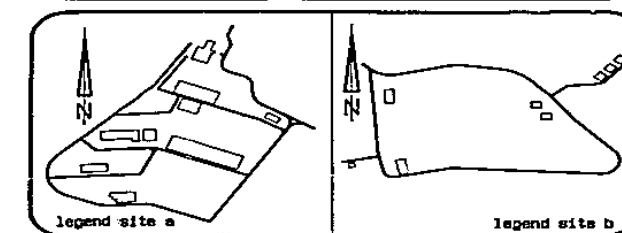

C. A. D.	DATE	BY	FILE NAME
01	04/01/99	HPH	BLD232P3
02			
03			
CONSULTANTS	DATE	BY	FILE NAME
01	04/01/99	HPH	BLD232P3
02			
03			
DATE	BY	FILE NAME
01	04/01/99	BLD232P3
02		
03		
AS BUILT 671/0002423 Z

SECOND FLOOR PLAN

SCALE 1:100

LIGHTING
SECURITY
COMMUNICATIONS
POWER

4 COMPARTMENT DUCTING SERVICES ALLOCATION

