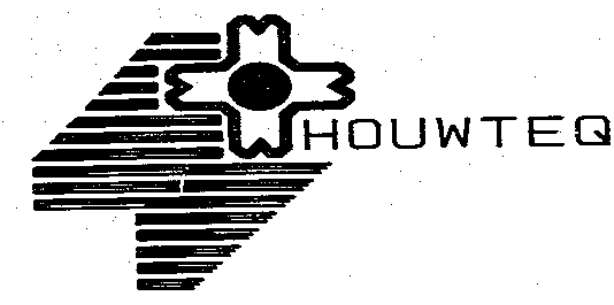


AS BUILT

DISTRIBUTION BOARD CONSTRUCTION						DISTRIBUTION BOARD ELECTRICAL SPECIFICATION							
RECESSED		LOCKABLE DOORS		COLOUR - MAIN	ELECTRIC ORANGE	WIDTH		BUSBAR RATING	160A	FRONT ACCESS	<input checked="" type="checkbox"/>	CABLE ENTRY: TOP	<input checked="" type="checkbox"/>
HALF-RECESSED		SEPERATE DIVISIONS		COLOUR - EMERGENCY		HEIGHT		FAULT LEVEL	5KA	REAR ACCESS	<input checked="" type="checkbox"/>	CABLE ENTRY: BOTTOM	<input checked="" type="checkbox"/>
SURFACE	<input checked="" type="checkbox"/>	EMERGENCY SECTION		COLOUR - UPS		DEPTH		FULL NEUTRAL		SUPPLY: SINGLE CORE	<input checked="" type="checkbox"/>	FUTURE EXPANSION	
FLOOR-STANDING	<input checked="" type="checkbox"/>	UPS SECTION		COLOUR - NORMAL	ELECTRIC ORANGE			HALF - NEUTRAL		SUPPLY: CABLE	<input checked="" type="checkbox"/>	CABLE ENTRY: REAR	
DOORS	<input checked="" type="checkbox"/>	NORMAL SECTION	<input checked="" type="checkbox"/>	SPARE SPACE	30 %			EQUIPMENT	MERLIN GERLIN	SUPPLY: BUSBAR	<input checked="" type="checkbox"/>	FUTURE EXPANSION	

REVISIONS	NO.		DATE	DESCRIPTION		BKS Inc. 'Ing				REV. Z		SCALE N.T.S.		TITLE		
	CONS. NO. BKS-4771/232/ZE/050					DESIGNED H. P. M.		DRAWN H. B/CAD		CHECKED H. P. M.		DATE SEPT 1990		SCHEMATIC - FIRST FLOOR		
														DB 232/SERVICE/N (NORMAL)		
														REV. Z		

DWS. NO. 671/000 2460	
-----------------------	--