



ELECTRICAL LEGEND
— DISTRIBUTION BOARD
— SURFACE MOUNTED 15A SBO (NORMAL)

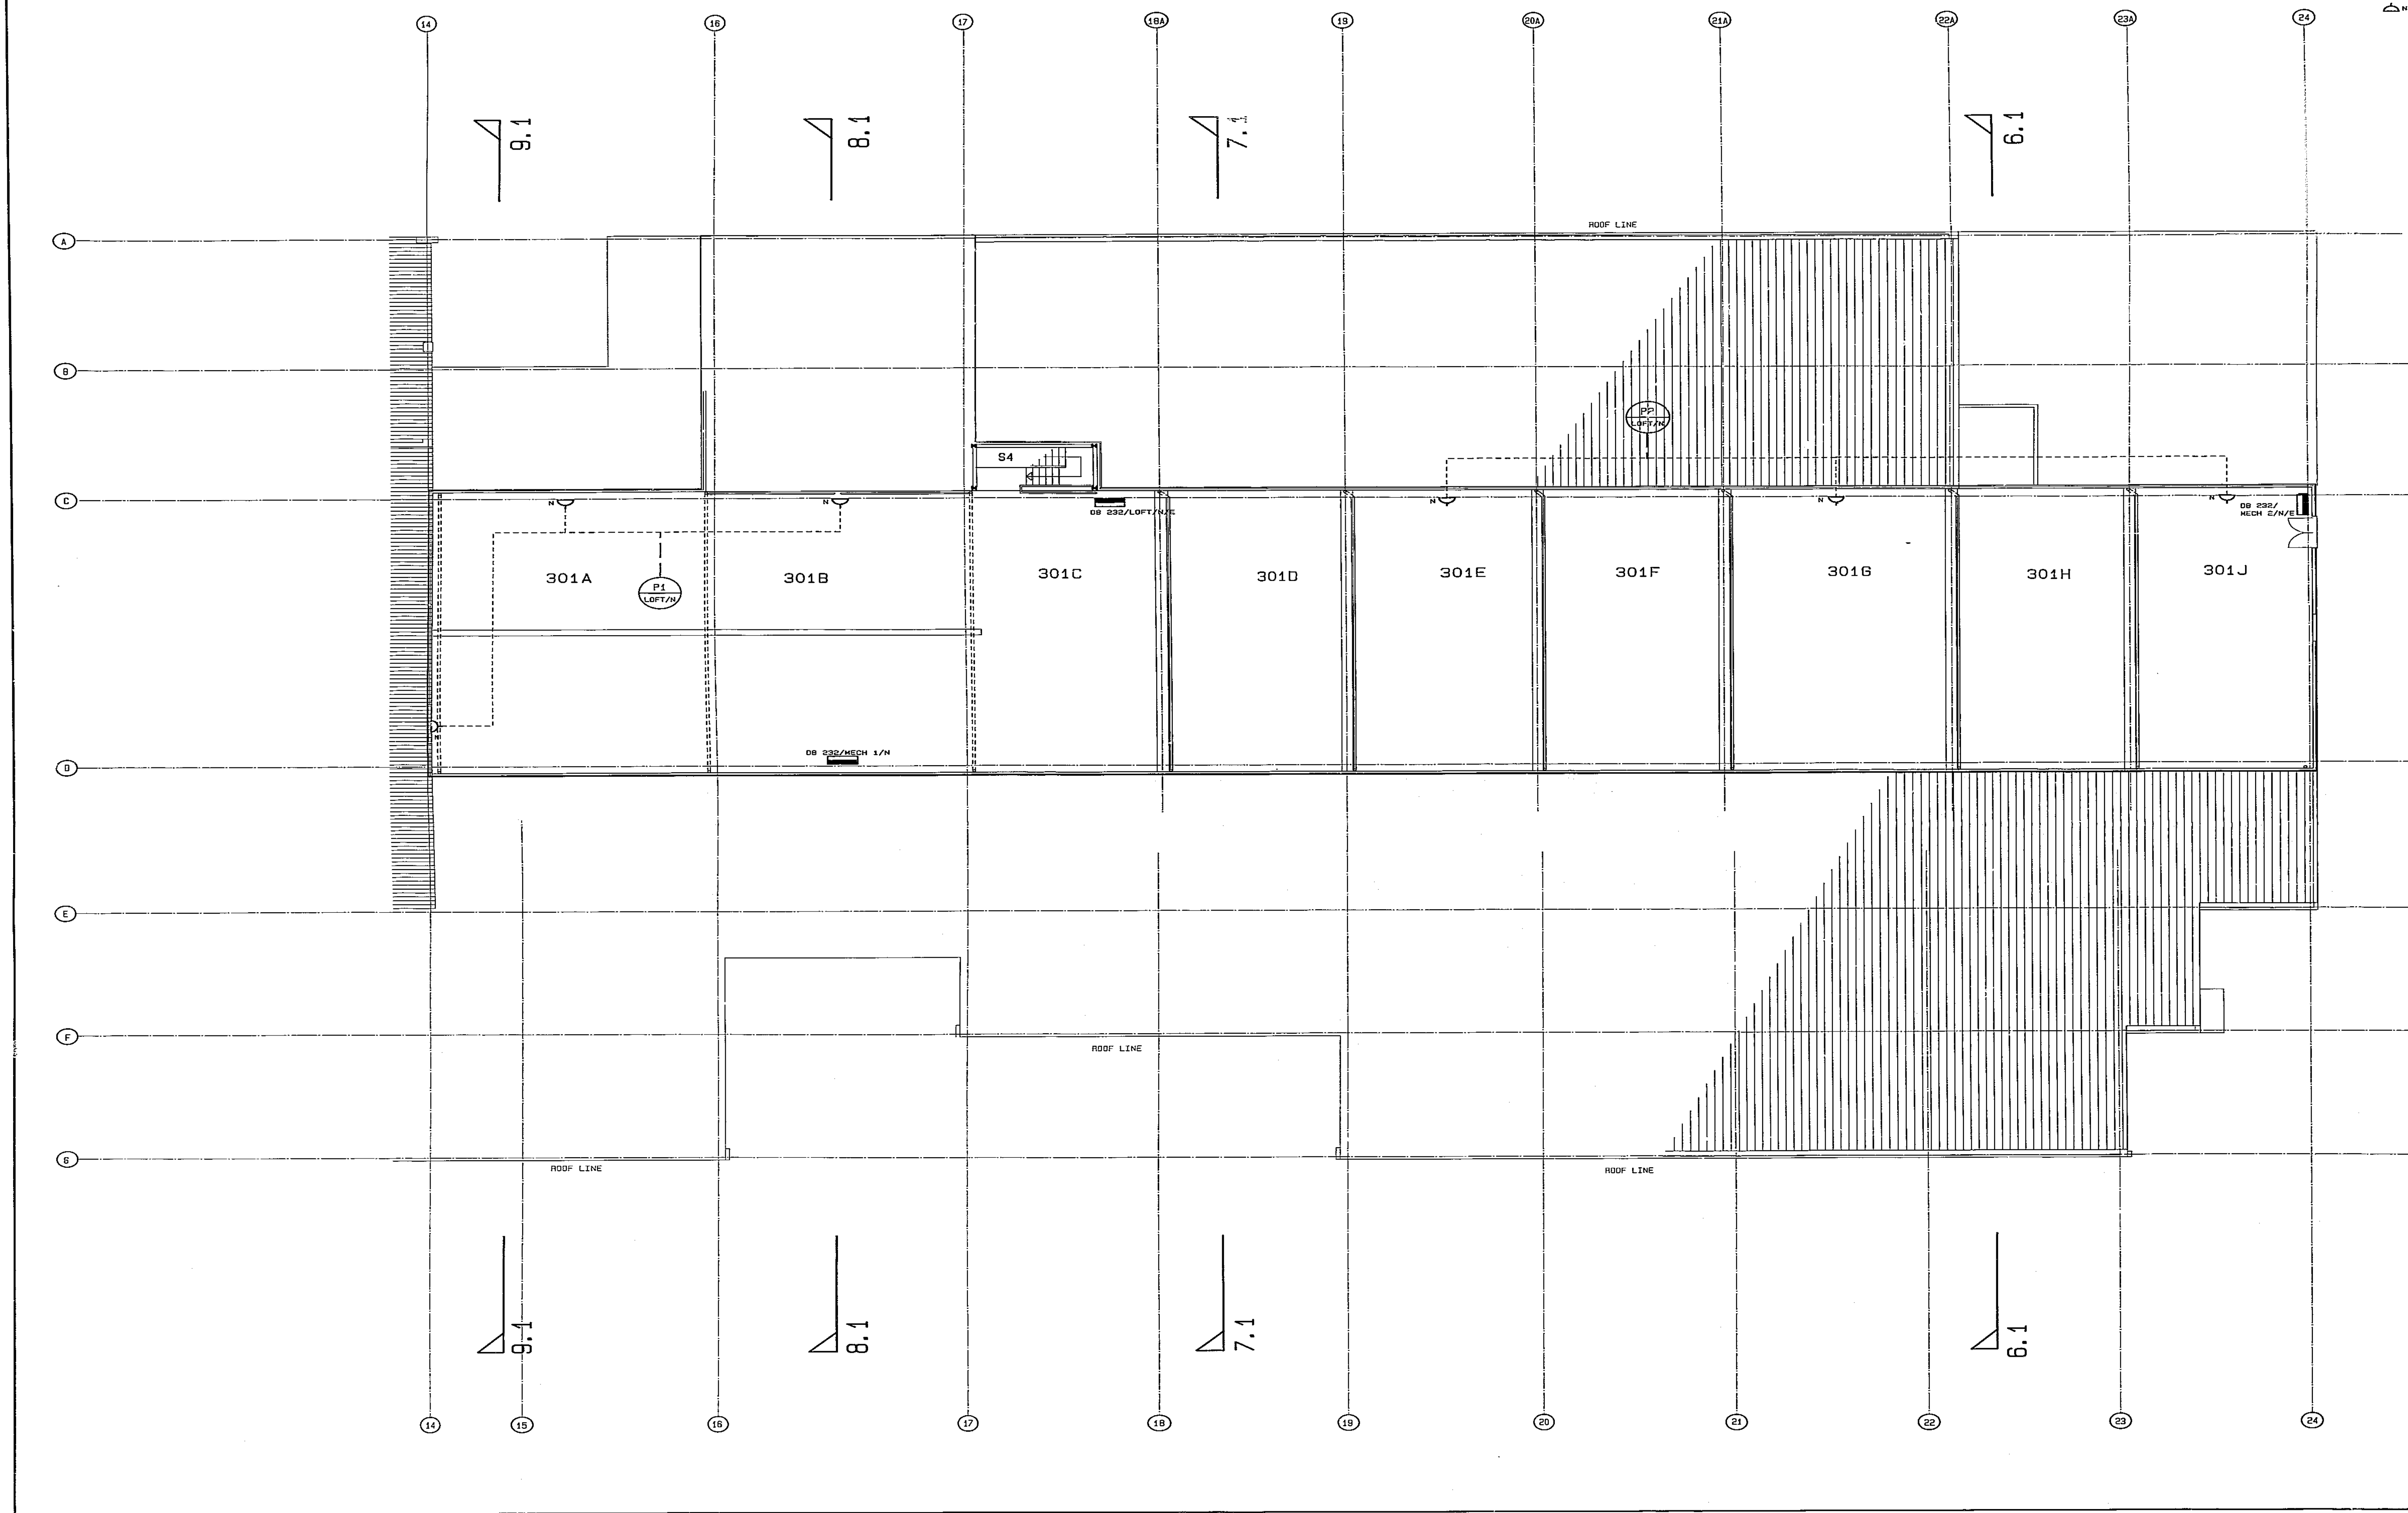

COPYRIGHT IS RESERVED ON THIS DRAWING

REV.	DATE	BY	REASON
01	02/25/99	WPM	CONSTRUCTION DRAWINGS
02			
03			
04			
05			
06			
07			
08			
09			
10			

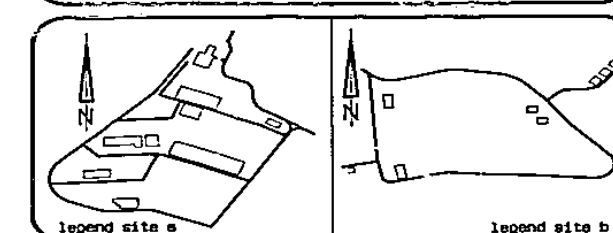

C. A. D.		FILE NAME
C:\A.D.		BL0232P4
LAYER	DESCRIPTION	PLOTTED
1	STRUCTURE	
2	FLOOR OUTLINE	
3	MECHANICAL	
4	DOORS & WINDOWS	
5	FITTINGS & FIXTURES	
6	SPRINKLER & RELATED TEXT	
7	PLUMBING & MECHANICAL LINES	
8	MECHANICAL	
9	OUTLINE AIDS	
10		
11		
12		
13	SEWER	
14	COMPUTER	
15		
DATE	OPERATOR	REVISION

CONSULTANTS	
BOO ENGINEERING CONSULTING ENGINEERS 1003 4400 870	REYNOLDS VAN NIEKERK & PARTNERS INC. CONSULTING ENGINEERS 1011 7800 4021 (021) 855500
WEDDERBURN VAN DER LEEUW, THOMAS & BONGERS ARCHITECTS 1001 7400 00	VAN NIEKERK, ALBERT & STRAUSS CONSULTING ENGINEERS 1011 7800 00



BUILDING 232 SITE A			
SERVICE FLOOR POWER LAYOUT			
PROJECT NO. P4771	DATE P4771/232/ZE/009	CONTR. NO. Z	SCALE 1:100
DATE AUG 1990	REVISION 671/0002419		

AS BUILT