


NOTES:
1. PUSHBUTTON WITH INTEGRAL
INDICATION LIGHT

AS BUILT

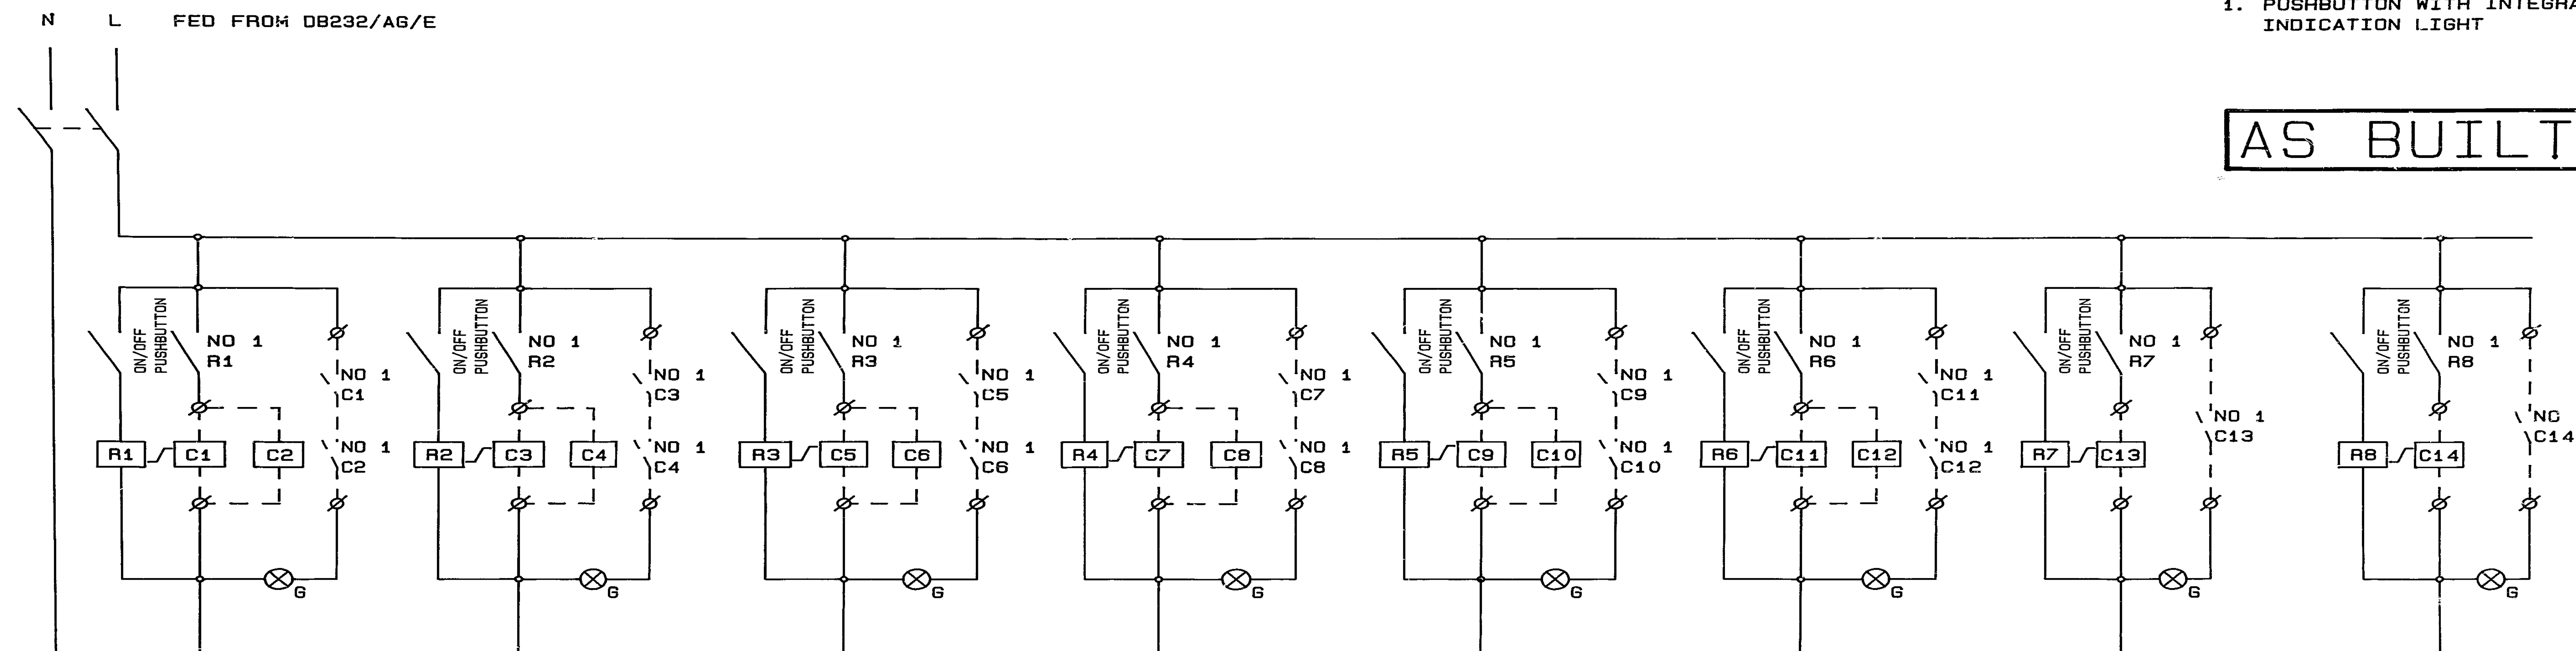

GROUND FLOOR LIGHTING
DB232/AG/N/E/C

FIRST FLOOR LIGHTING
DB232/A1/N/E/C

SECOND FLOOR LIGHTING
DB232/A2/N/E/C

GROUND FLOOR LIGHTING/AREA 39
DB232/COMPUTER/N/E/C

TASK AREA LIGHTING
AREA 3/4/5/6
DB232/G5/N/E/C

MAIN TASK AREA LIGHTING
DB232/LOFT/N/E

OUTSIDE LIGHTING (FRONT)
DB232/AG/N/E/C


OUTSIDE LIGHTING (BACK)
DB232/LOCAL/N/E

DISTRIBUTION BOARD CONSTRUCTION

RECESSED	<input checked="" type="checkbox"/>	LOCKABLE DOORS	<input checked="" type="checkbox"/>	COLOUR - MAIN	ELECTRICAL ORANGE	WIDTH	
HALF-RECESSED	<input type="checkbox"/>	SEPERATE DIVISIONS	<input type="checkbox"/>	COLOUR - EMERGENCY	RED	HEIGHT	
SURFACE	<input type="checkbox"/>	EMERGENCY SECTION	<input type="checkbox"/>	COLOUR - UPS		DEPTH	
FLOOR-STANDING	<input type="checkbox"/>	UPS SECTION	<input type="checkbox"/>	COLOUR - NORMAL			
DOORS	<input checked="" type="checkbox"/>	NORMAL SECTION	<input type="checkbox"/>	SPARE SPACE	30%		

DISTRIBUTION BOARD ELECTRICAL SPECIFICATION

BUSBAR RATING		FRONT ACCESS	<input checked="" type="checkbox"/>	CABLE ENTRY: TOP	<input checked="" type="checkbox"/>
FAULT LEVEL	5KA	REAR ACCESS	<input type="checkbox"/>	CABLE ENTRY: BOTTOM	<input type="checkbox"/>
FULL NEUTRAL		SUPPLY: SINGLE CORE	<input checked="" type="checkbox"/>	FUTURE EXPANSION	<input type="checkbox"/>
HALF - NEUTRAL		SUPPLY: CABLE	<input type="checkbox"/>		
EQUIPMENT		SUPPLY: BUSBAR	<input type="checkbox"/>		

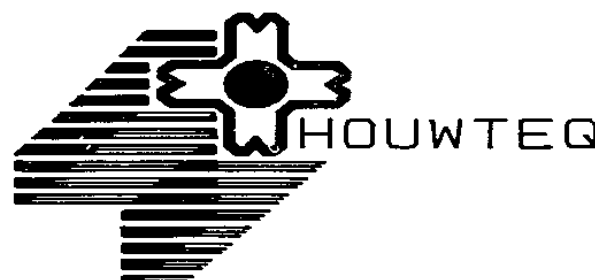REVISIONS				BKS Inc./Ing			TITLE SCHEMATIC		
				CONS. NO. BKS-4771/232/ZE/075			CENTRAL LIGHTING CONTROL PANEL		
				DESIGNED H. P. M.	DRAWN H. B/CAD	CHECKED H. P. M.	DATE MARCH 91	DWG. NO. 671/000 2487	REV. Z
	NO.	DATE	DESCRIPTION						