


AS BUILT

FED FROM DB 232/MAIN/N


160A  
C161NI

- NOTES:  
1. PS = POWERSKIRTING  
2. THIS SECTION FORMS PART OF  
A THREE COMPARTMENT DB

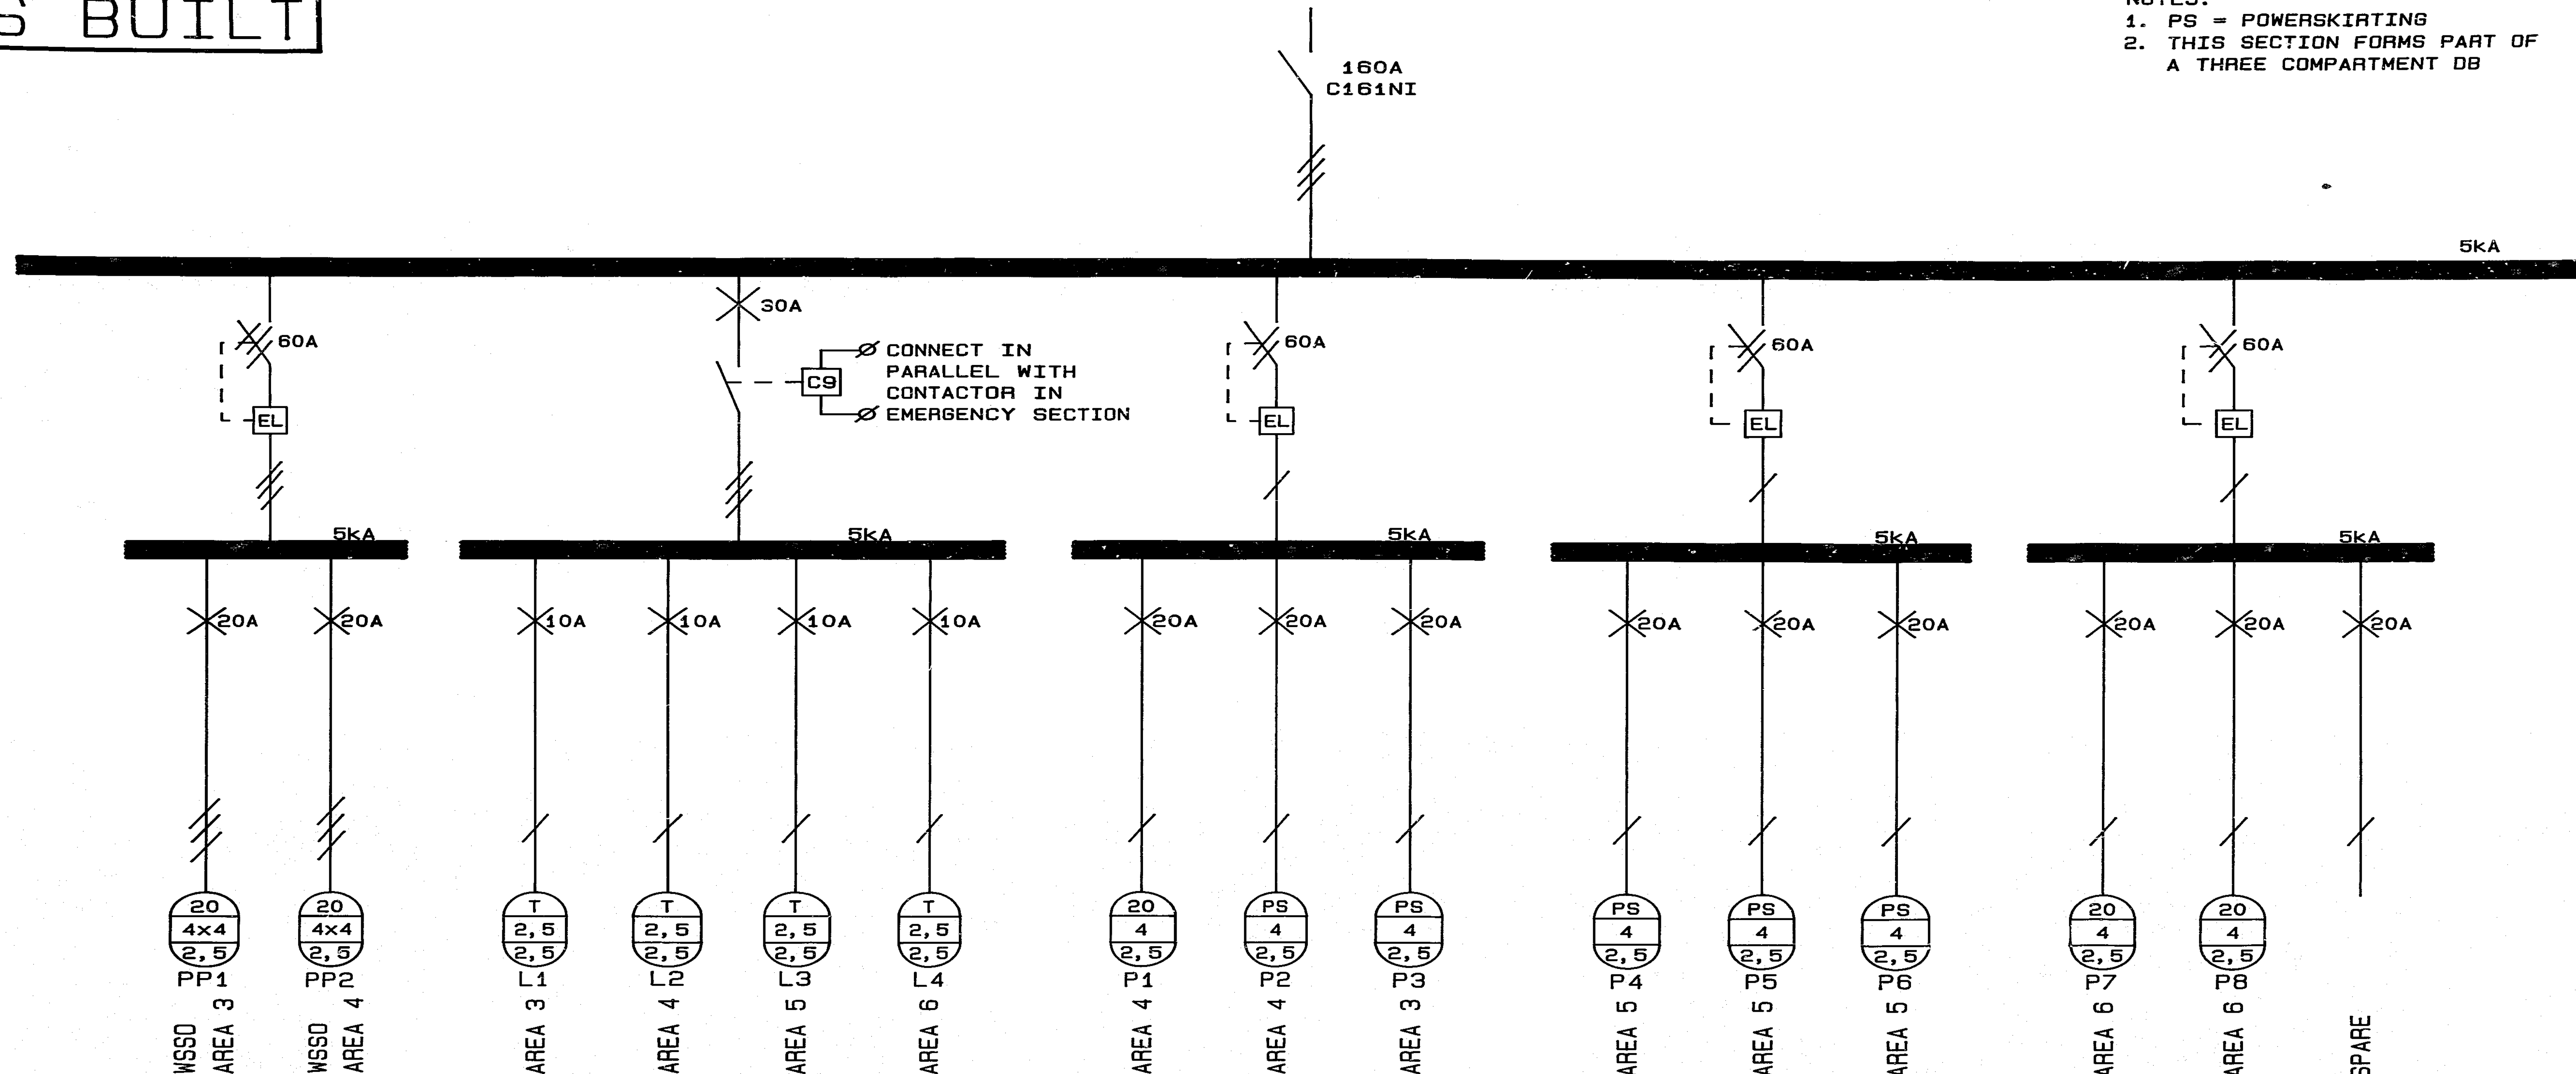

DISTRIBUTION BOARD CONSTRUCTION						DISTRIBUTION BOARD ELECTRICAL SPECIFICATION					
RECESSED	<input checked="" type="checkbox"/>	LOCKABLE DOORS	<input checked="" type="checkbox"/>	COLOUR - MAIN	ELECTRICAL ORANGE	BUSBAR RATING	160A	FRONT ACCESS	<input checked="" type="checkbox"/>	CABLE ENTRY: TOP	<input checked="" type="checkbox"/>
HALF-RECESSED	<input type="checkbox"/>	SEPERATE DIVISIONS	<input checked="" type="checkbox"/>	COLOUR - EMERGENCY	RED	FAULT LEVEL	5kA	REAR ACCESS	<input type="checkbox"/>	CABLE ENTRY: BOTTOM	<input type="checkbox"/>
SURFACE	<input type="checkbox"/>	EMERGENCY SECTION	<input checked="" type="checkbox"/>	COLOUR - UPS	VERDIGRIS GREEN	FULL NEUTRAL	<input checked="" type="checkbox"/>	SUPPLY: SINGLE CORE	<input checked="" type="checkbox"/>	FUTURE EXPANSION	<input type="checkbox"/>
FLOOR-STANDING	<input type="checkbox"/>	UPS SECTION	<input checked="" type="checkbox"/>	COLOUR - NORMAL	ELECTRICAL ORANGE	HALF - NEUTRAL	<input type="checkbox"/>	SUPPLY: CABLE	<input checked="" type="checkbox"/>	CABLE ENTRY: REAR	<input type="checkbox"/>
DOORS	<input checked="" type="checkbox"/>	NORMAL SECTION	<input checked="" type="checkbox"/>	SPARE SPACE	30 %	EQUIPMENT	MERLIN GERIN	SUPPLY: BUSBAR	<input type="checkbox"/>	FUTURE EXPANSION	<input type="checkbox"/>

REVISIONS	NO.	DATE	DESCRIPTION



BKS Inc. /Ing

CONS. NO. BKS-4771/232/ZE/045

DESIGNED H. P. M. DRAWN H. B/CAD CHECKED H. P. M. DATE SEPT 1990

REV. Z SCALE N. T. S.

TITLE SCHEMATIC - GROUND FLOOR DB 232/65/N (NORMAL)

DWG. NO. 671/000 2455

REV. Z