


- ELECTRICAL LEGEND
- FLUSH MOUNTED TELEPHONE POINT (COMMS) (4x4 BOX)
  - 25mm Ø UNLESS OTHERWISE SPECIFIED
  - FLUSH MOUNTED CARD READER OUTLET (SEC) (4x4 BOX)
  - FLUSH MOUNTED MONITORING POINT (COMMS) (4x4 BOX)
  - DOOR MONITOR OUTLET (SEC) (4x4 BOX)
  - 4 COMPARTMENT TRUNKING (LIGHTING POWER, SECURITY AND COMMUNICATIONS)
  - FLUSH MOUNTED MOTION DETECTOR (SEC) (50mm Ø ROUND OUTLET BOX)
  - THREE OR FOUR WAY CROSSOVER AS PER DETAIL DRAWINGS

1. 90° FOUR COMPARTMENT DUCTING BENDS TO BE RADIUS

COPYRIGHT IS RESERVED ON THIS DRAWING

REV.	DATE	BY	REASON
01			
02	02/08/94	HPM	CONSTRUCTION DRAWINGS
03	04/08/94	HPM	ADDED DUCTING INTERLINKS - UNTESTED
04			CONSOLE DRAWING IN ROOM 114
05			
06			
07			
08			

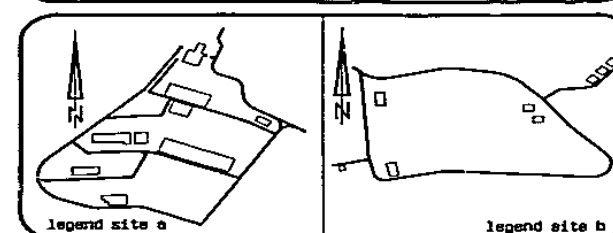

LAYER	DESCRIPTION	PLotted
1	STRUCTURE	
2	FLOOR SLABS	
3	MASONRY	
4	DOOR & WINDOWS	
5	FITTINGS & FIXTURES	
6	AS-BUILT & RELATED TEST	
7	TEST & SECTION LINES	
8	REVISIONS	
9	CELLING	
10	CEILING MESH	
11		
12		
13	SEWER	
14	STORMWATER	
15		

CONSULTANTS	
BKS IMR/IMC CONSULTING ENGINEERS (021) 9481070	JEFFRIES, VAN NEESEN & PARTNERS INC. CONSULTING ENGINEERS (011) 7828493 (021) 6855000
MEIRINS, VAN DER LEEUW, THOMAS & BONGA ARCHITECTS (021) 843250	VAN NEESEN, KLEYN & EDWARDS CONSULTING ENGINEERS (021) 232261

**HAASVLAKTE**

for contract: date for booking: date

1101

**BUILDING 232**

**SITE A**

1101

**FIRST FLOOR SECURITY, COMMUNICATIONS AND DATA LAYOUT**

CONTRACT NO.	CONTRACT NO.	CONTRACT NO.
P4771	P4771/232/ZE/012	Z
DATE	DATE	DATE
18/08/94	AUG 1994	1:100
DATE	DATE	DATE

AS BUILT 671/0002422 Z

FIRST FLOOR PLAN  
SCALE 1:100

POWER
SECURITY
COMMUNICATIONS
3 COMPARTMENT POWER/SECURITY SERVICES ALLOCATION
LIGHTING
SECURITY
COMMUNICATIONS
POWER
4 COMPARTMENT DUCTING SERVICES ALLOCATION