


FED FROM DB 232/MAIN/C

160A
C161NI

5kA

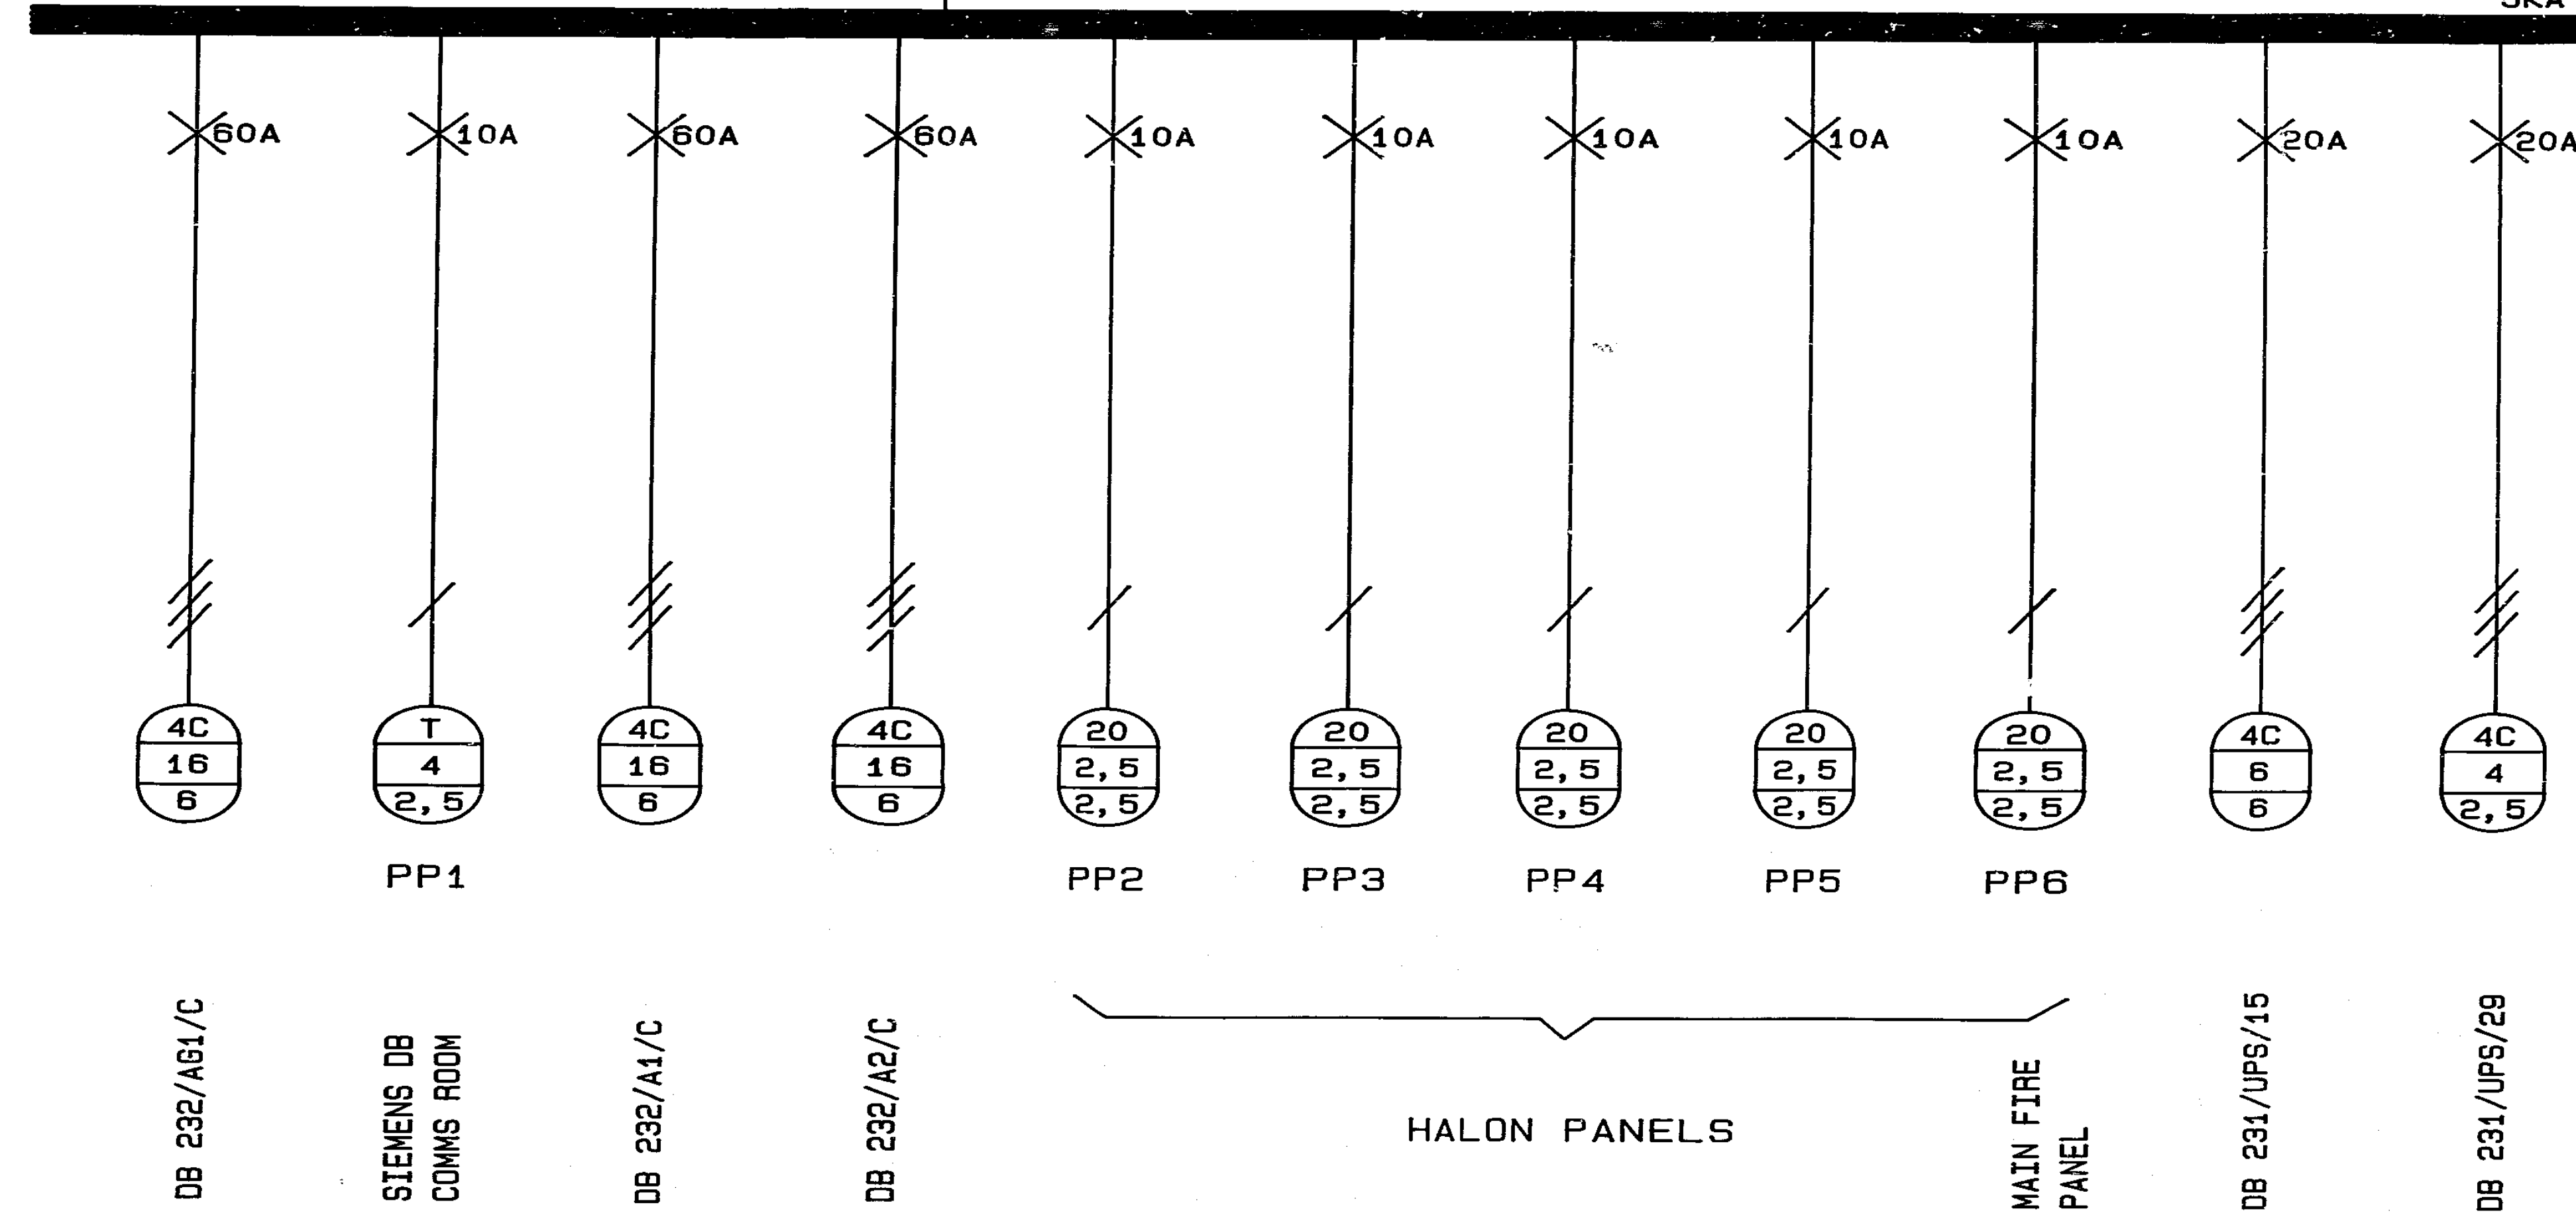

- NOTES:
1. T = TRUNKING
 2. THIS SECTION FORMS PART OF A THREE COMPARTMENT DB
 3. ALL EARTH WIRE SHALL BE INSULATED

AS BUILT


DISTRIBUTION BOARD CONSTRUCTION

RECESSED		LOCKABLE DOORS	<input checked="" type="checkbox"/>	COLOUR - MAIN	ELECTRICAL ORANGE	WIDTH	
HALF-RECESSED		SEPERATE DIVISIONS	<input checked="" type="checkbox"/>	COLOUR - EMERGENCY	RED	HEIGHT	
SURFACE		EMERGENCY SECTION	<input checked="" type="checkbox"/>	COLOUR - UPS	VERDIGRIS GREEN	DEPTH	
FLOOR-STANDING		UPS SECTION	<input checked="" type="checkbox"/>	COLOUR - NORMAL	ELECTRICAL ORANGE		
DOORS		NORMAL SECTION	<input checked="" type="checkbox"/>	SPARE SPACE	30 %		

DISTRIBUTION BOARD ELECTRICAL SPECIFICATION

BUSBAR RATING	160A	FRONT ACCESS	<input checked="" type="checkbox"/>	CABLE ENTRY: TOP	<input checked="" type="checkbox"/>
FAULT LEVEL	5kA	REAR ACCESS	<input checked="" type="checkbox"/>	CABLE ENTRY: BOTTOM	<input checked="" type="checkbox"/>
FULL NEUTRAL		SUPPLY: SINGLE CORE	<input checked="" type="checkbox"/>	FUTURE EXPANSION	
HALF - NEUTRAL		SUPPLY: CABLE	<input checked="" type="checkbox"/>	CABLE ENTRY: REAR	
EQUIPMENT	MERLIN GERIN	SUPPLY: BUSBAR	<input checked="" type="checkbox"/>	FUTURE EXPANSION	

REVISIONS	1	02/91	DELETED 30x20A MCB. ADDED FEED TO AG1/C AND 5x10A MCB FOR HALON FEEDS
NO.	DATE	DESCRIPTION	

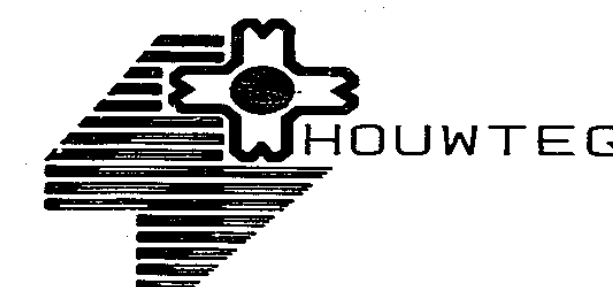

BKS Inc./Ing

CONS. NO.
BKS-4771/232/ZE/036

DESIGNED
H. P. M.

DRAWN
H. B/CAD

CHECKED
H. P. M.

REV.
Z

SCALE
N. T. S.

DATE
SEPT 1990

TITLE
SCHEMATIC -GROUND FLOOR
DB 232/AG/C (CLEAN)

DWG. NO.
671/000 2446

REV.
Z