


AS BUILT

FED FROM DB232/AG/N


160A  
CI6I NI

NOTES:

- (1) T = TRUNKING  
(2) THIS SECTION FORMS PART OF A  
THREE COMPARTMENT DB.

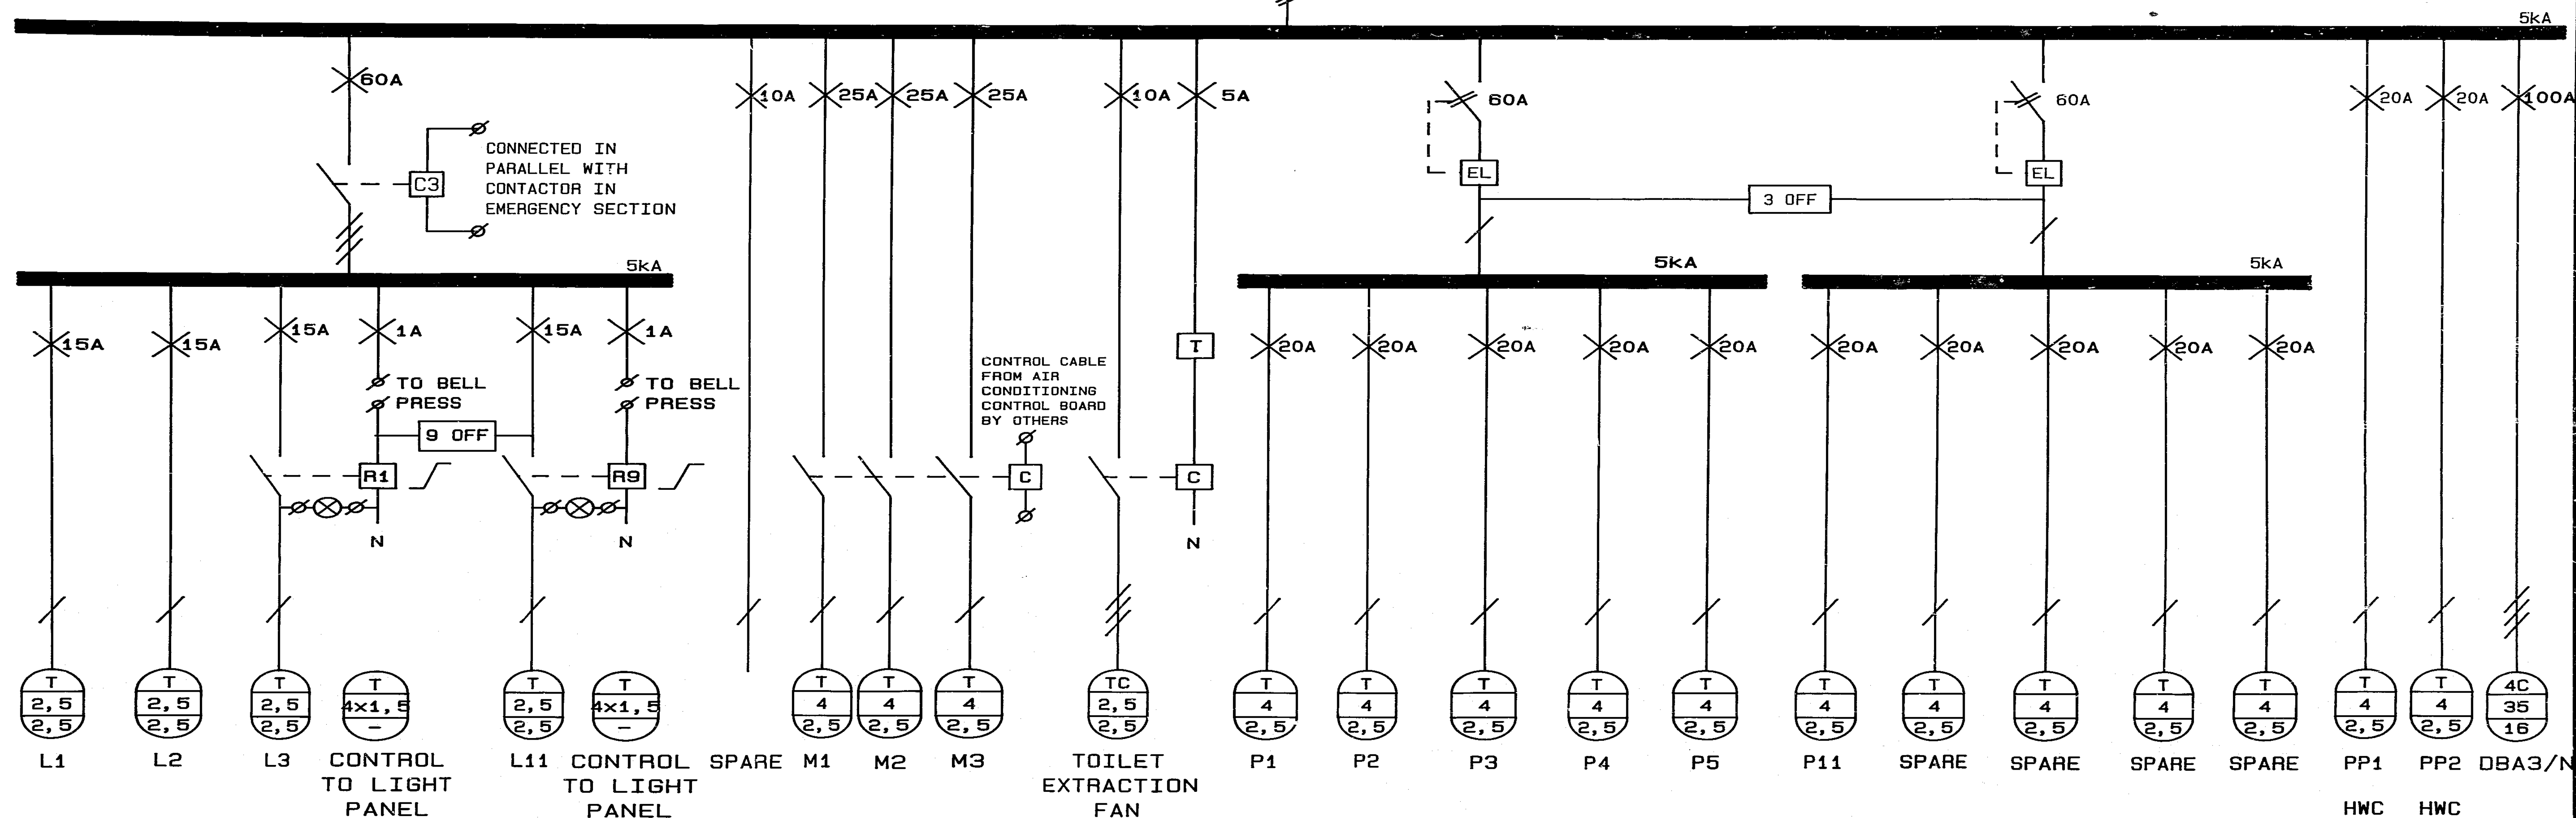

DISTRIBUTION BOARD CONSTRUCTION								DISTRIBUTION BOARD ELECTRICAL SPECIFICATION					
RECESSED		LOCKABLE DOORS		COLOUR - MAIN	ELECTRIC ORANGE	WIDTH	---	BUSBAR RATING	160A	FRONT ACCESS	<input checked="" type="checkbox"/>	CABLE ENTRY: TOP	<input checked="" type="checkbox"/>
HALF-RECESSED		SEPERATE DIVISIONS	<input checked="" type="checkbox"/>	COLOUR - EMERGENCY	RED	HEIGHT	---	FAULT LEVEL	5kA	REAR ACCESS	<input checked="" type="checkbox"/>	CABLE ENTRY: BOTTOM	<input checked="" type="checkbox"/>
SURFACE	<input checked="" type="checkbox"/>	EMERGENCY SECTION	<input checked="" type="checkbox"/>	COLOUR - UPS	VERDIGRIS GREEN	DEPTH	---	FULL NEUTRAL	<input checked="" type="checkbox"/>	SUPPLY: SINGLE CORE	<input checked="" type="checkbox"/>	FUTURE EXPANSION	<input checked="" type="checkbox"/>
FLOOR-STANDING	<input checked="" type="checkbox"/>	UPS SECTION	<input checked="" type="checkbox"/>	COLOUR - NORMAL	ELECTRIC ORANGE			HALF - NEUTRAL	<input checked="" type="checkbox"/>	SUPPLY: CABLE	<input checked="" type="checkbox"/>	CABLE ENTRY: REAR	<input checked="" type="checkbox"/>
DOORS	<input checked="" type="checkbox"/>	NORMAL SECTION	<input checked="" type="checkbox"/>	SPARE SPACE	30%			EQUIPMENT	MERLIN GERIN	SUPPLY: BUSBAR	<input checked="" type="checkbox"/>	FUTURE EXPANSION	<input checked="" type="checkbox"/>

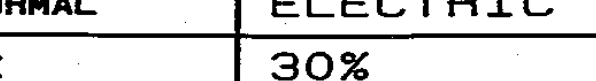REVISIONS	1	02/91	ADDED FEED TO MECH 8			BKS Inc./Ing			TITLE					
						CONS. NO.		REV.	SCALE	SCHEMATIC - FIRST FLOOR DB 232/A1/N (NORMAL)				
						BKS-4771/232/ZE/037		Z	N. T. S.					
						DESIGNED		DRAWN	CHECKED			DATE	DWS. NO.	REV.
						H. P. M.		W. G/CAD	H. P. M.			SEPT 1990	671/0002447	Z