

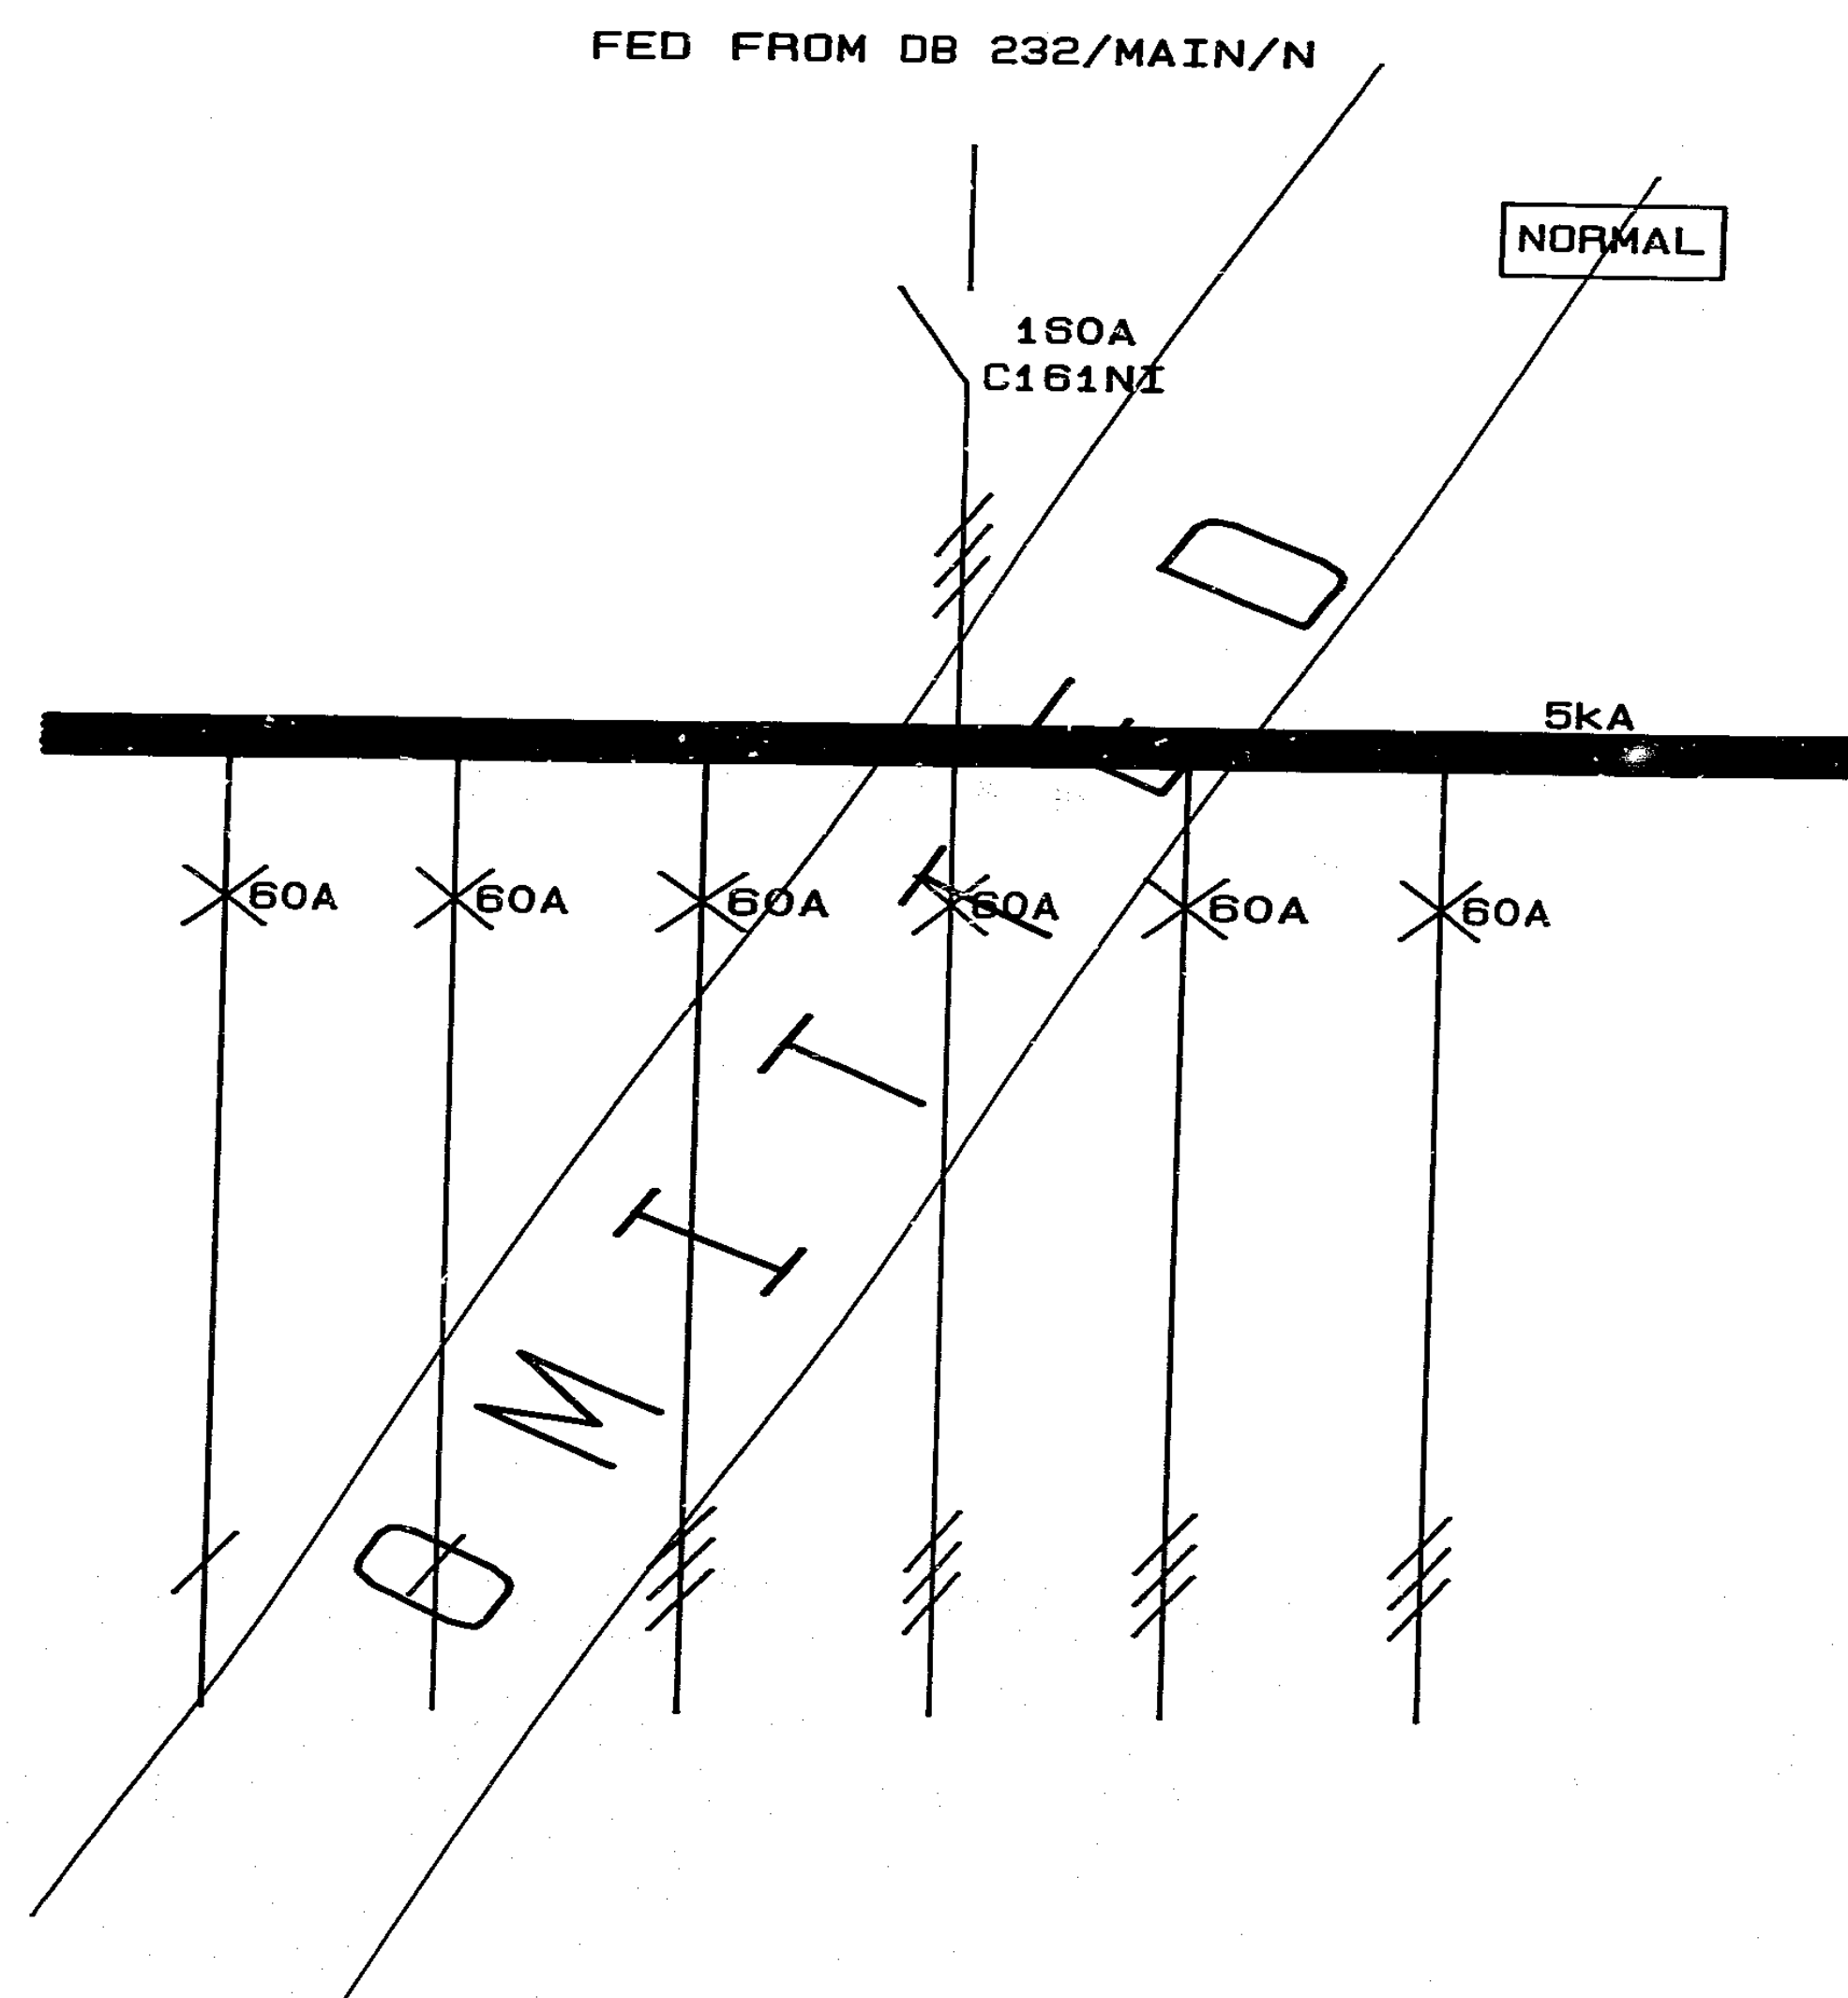


NOTES:
1. ALL EARTH WIRE
SHALL BE INSULATED

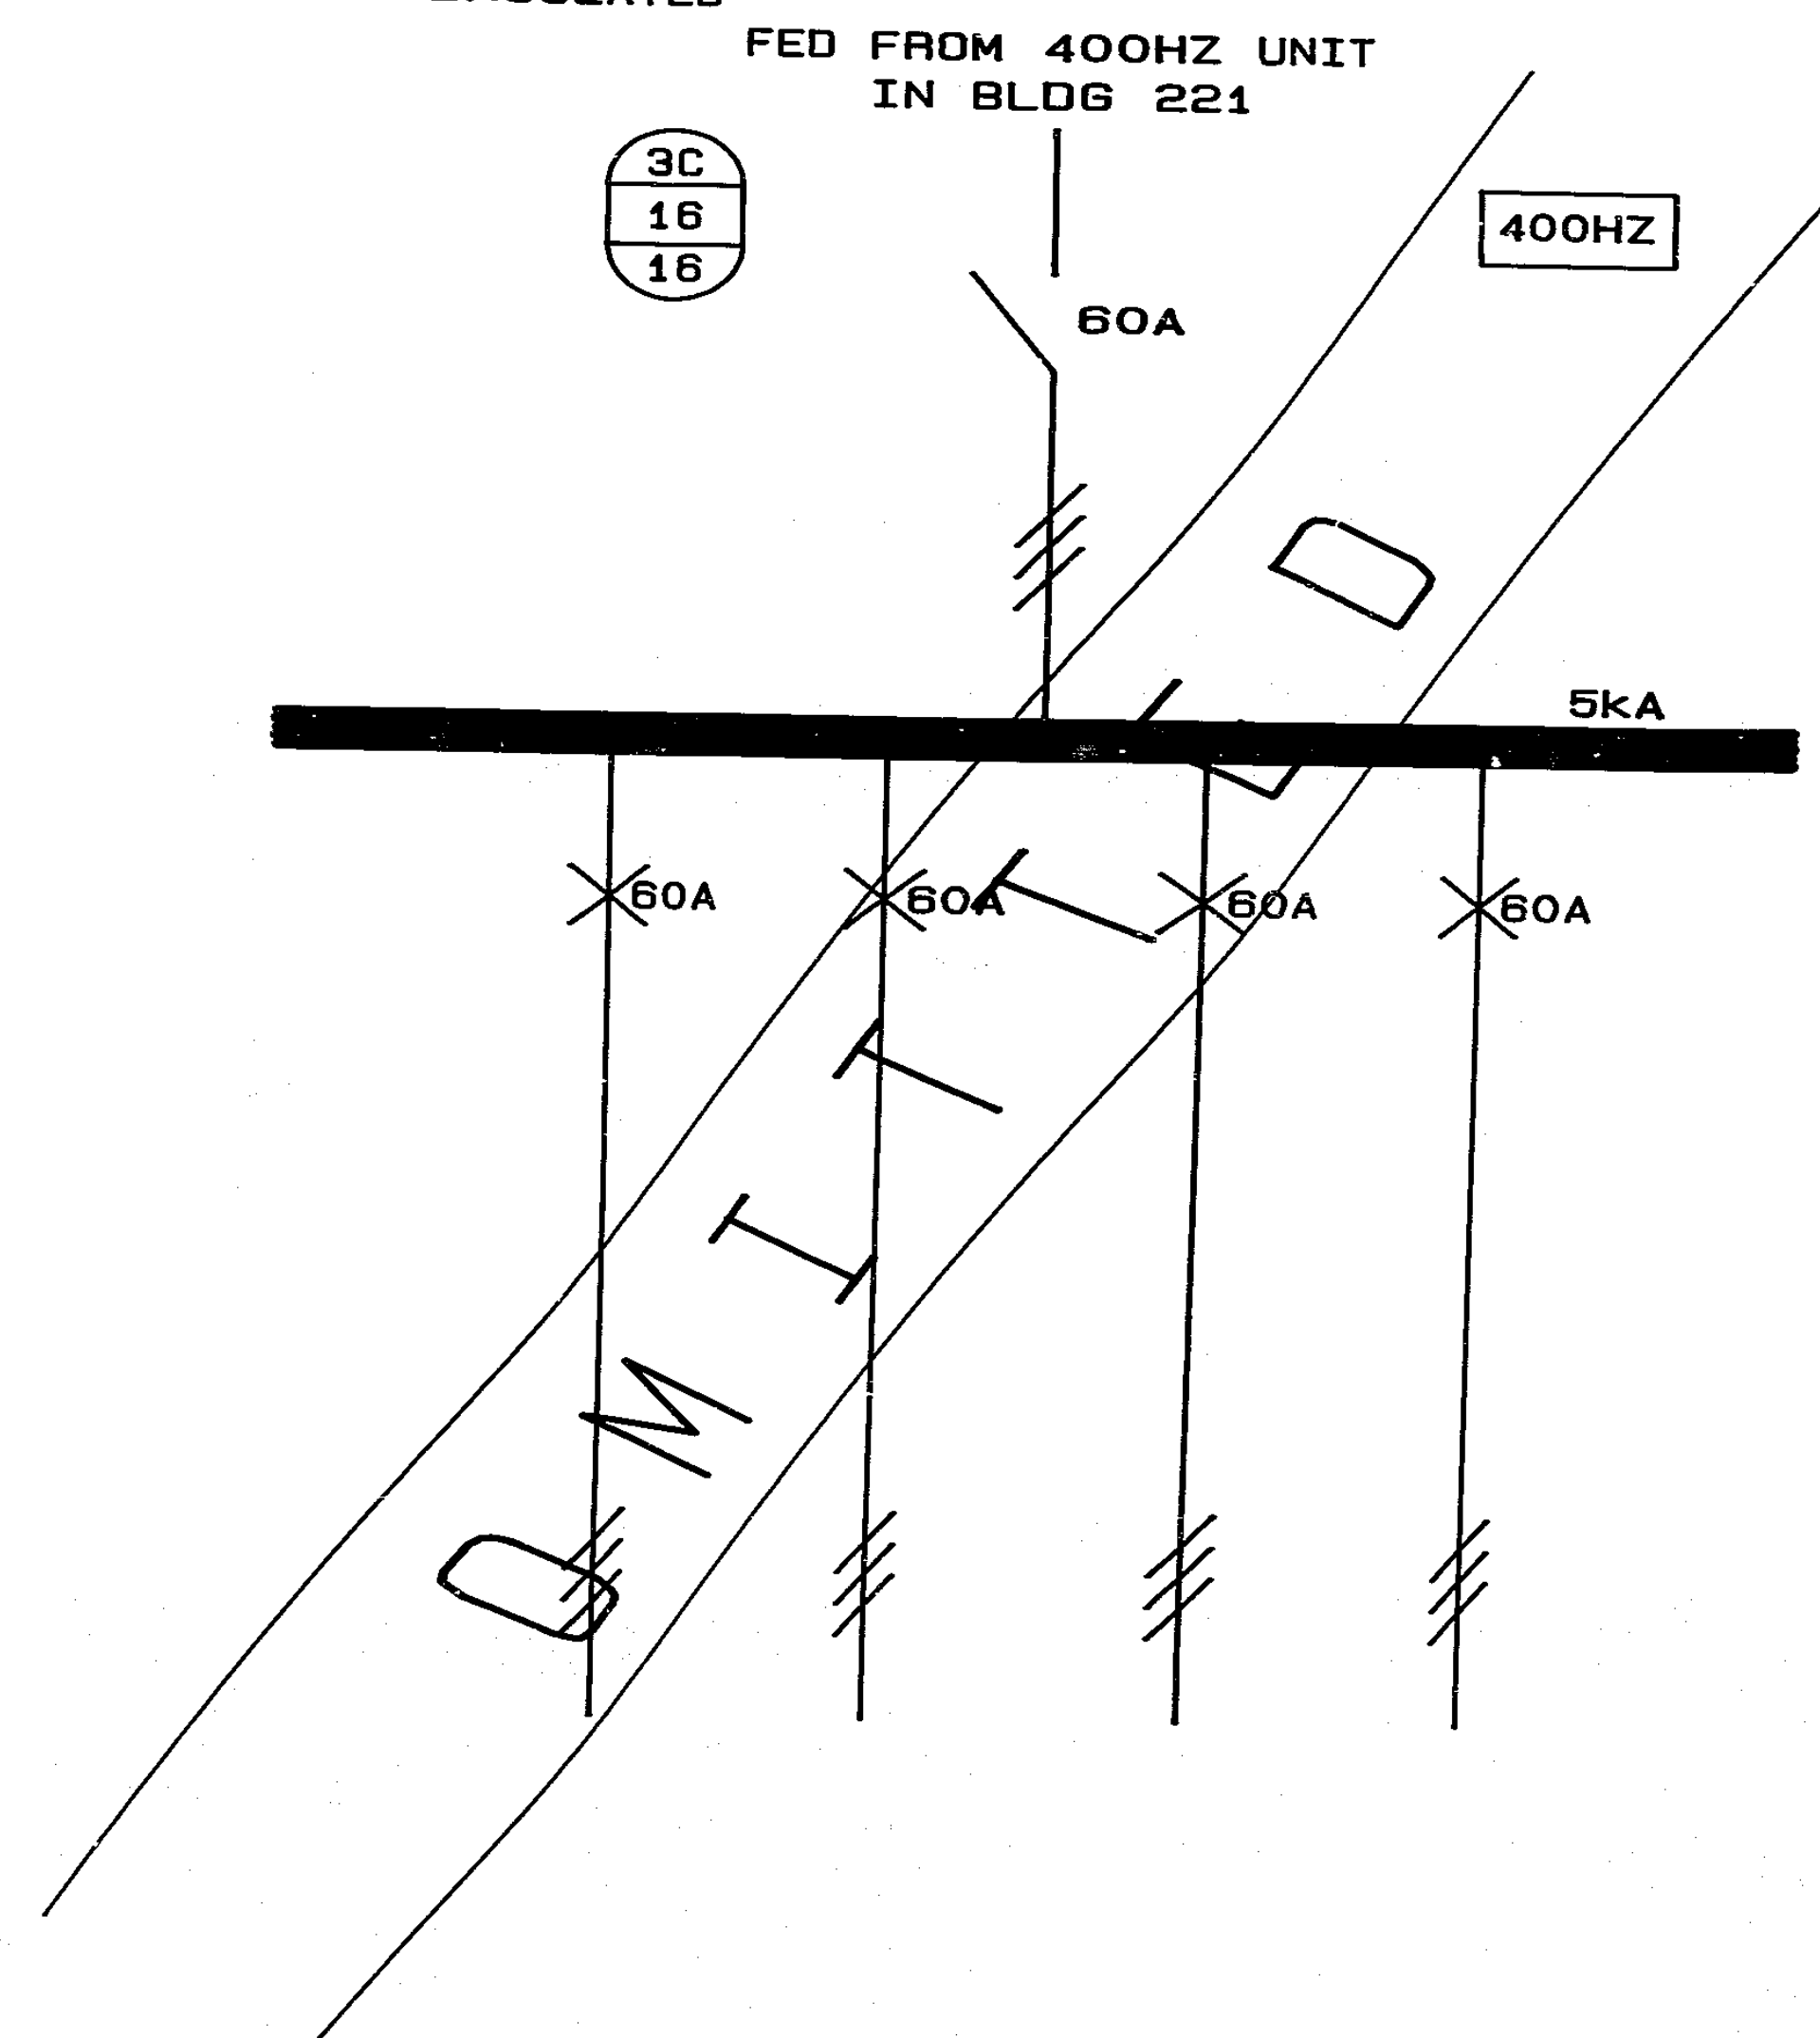

REFER TO SIEMENS AS BUILT
DRAWINGS FOR EMC ROOM

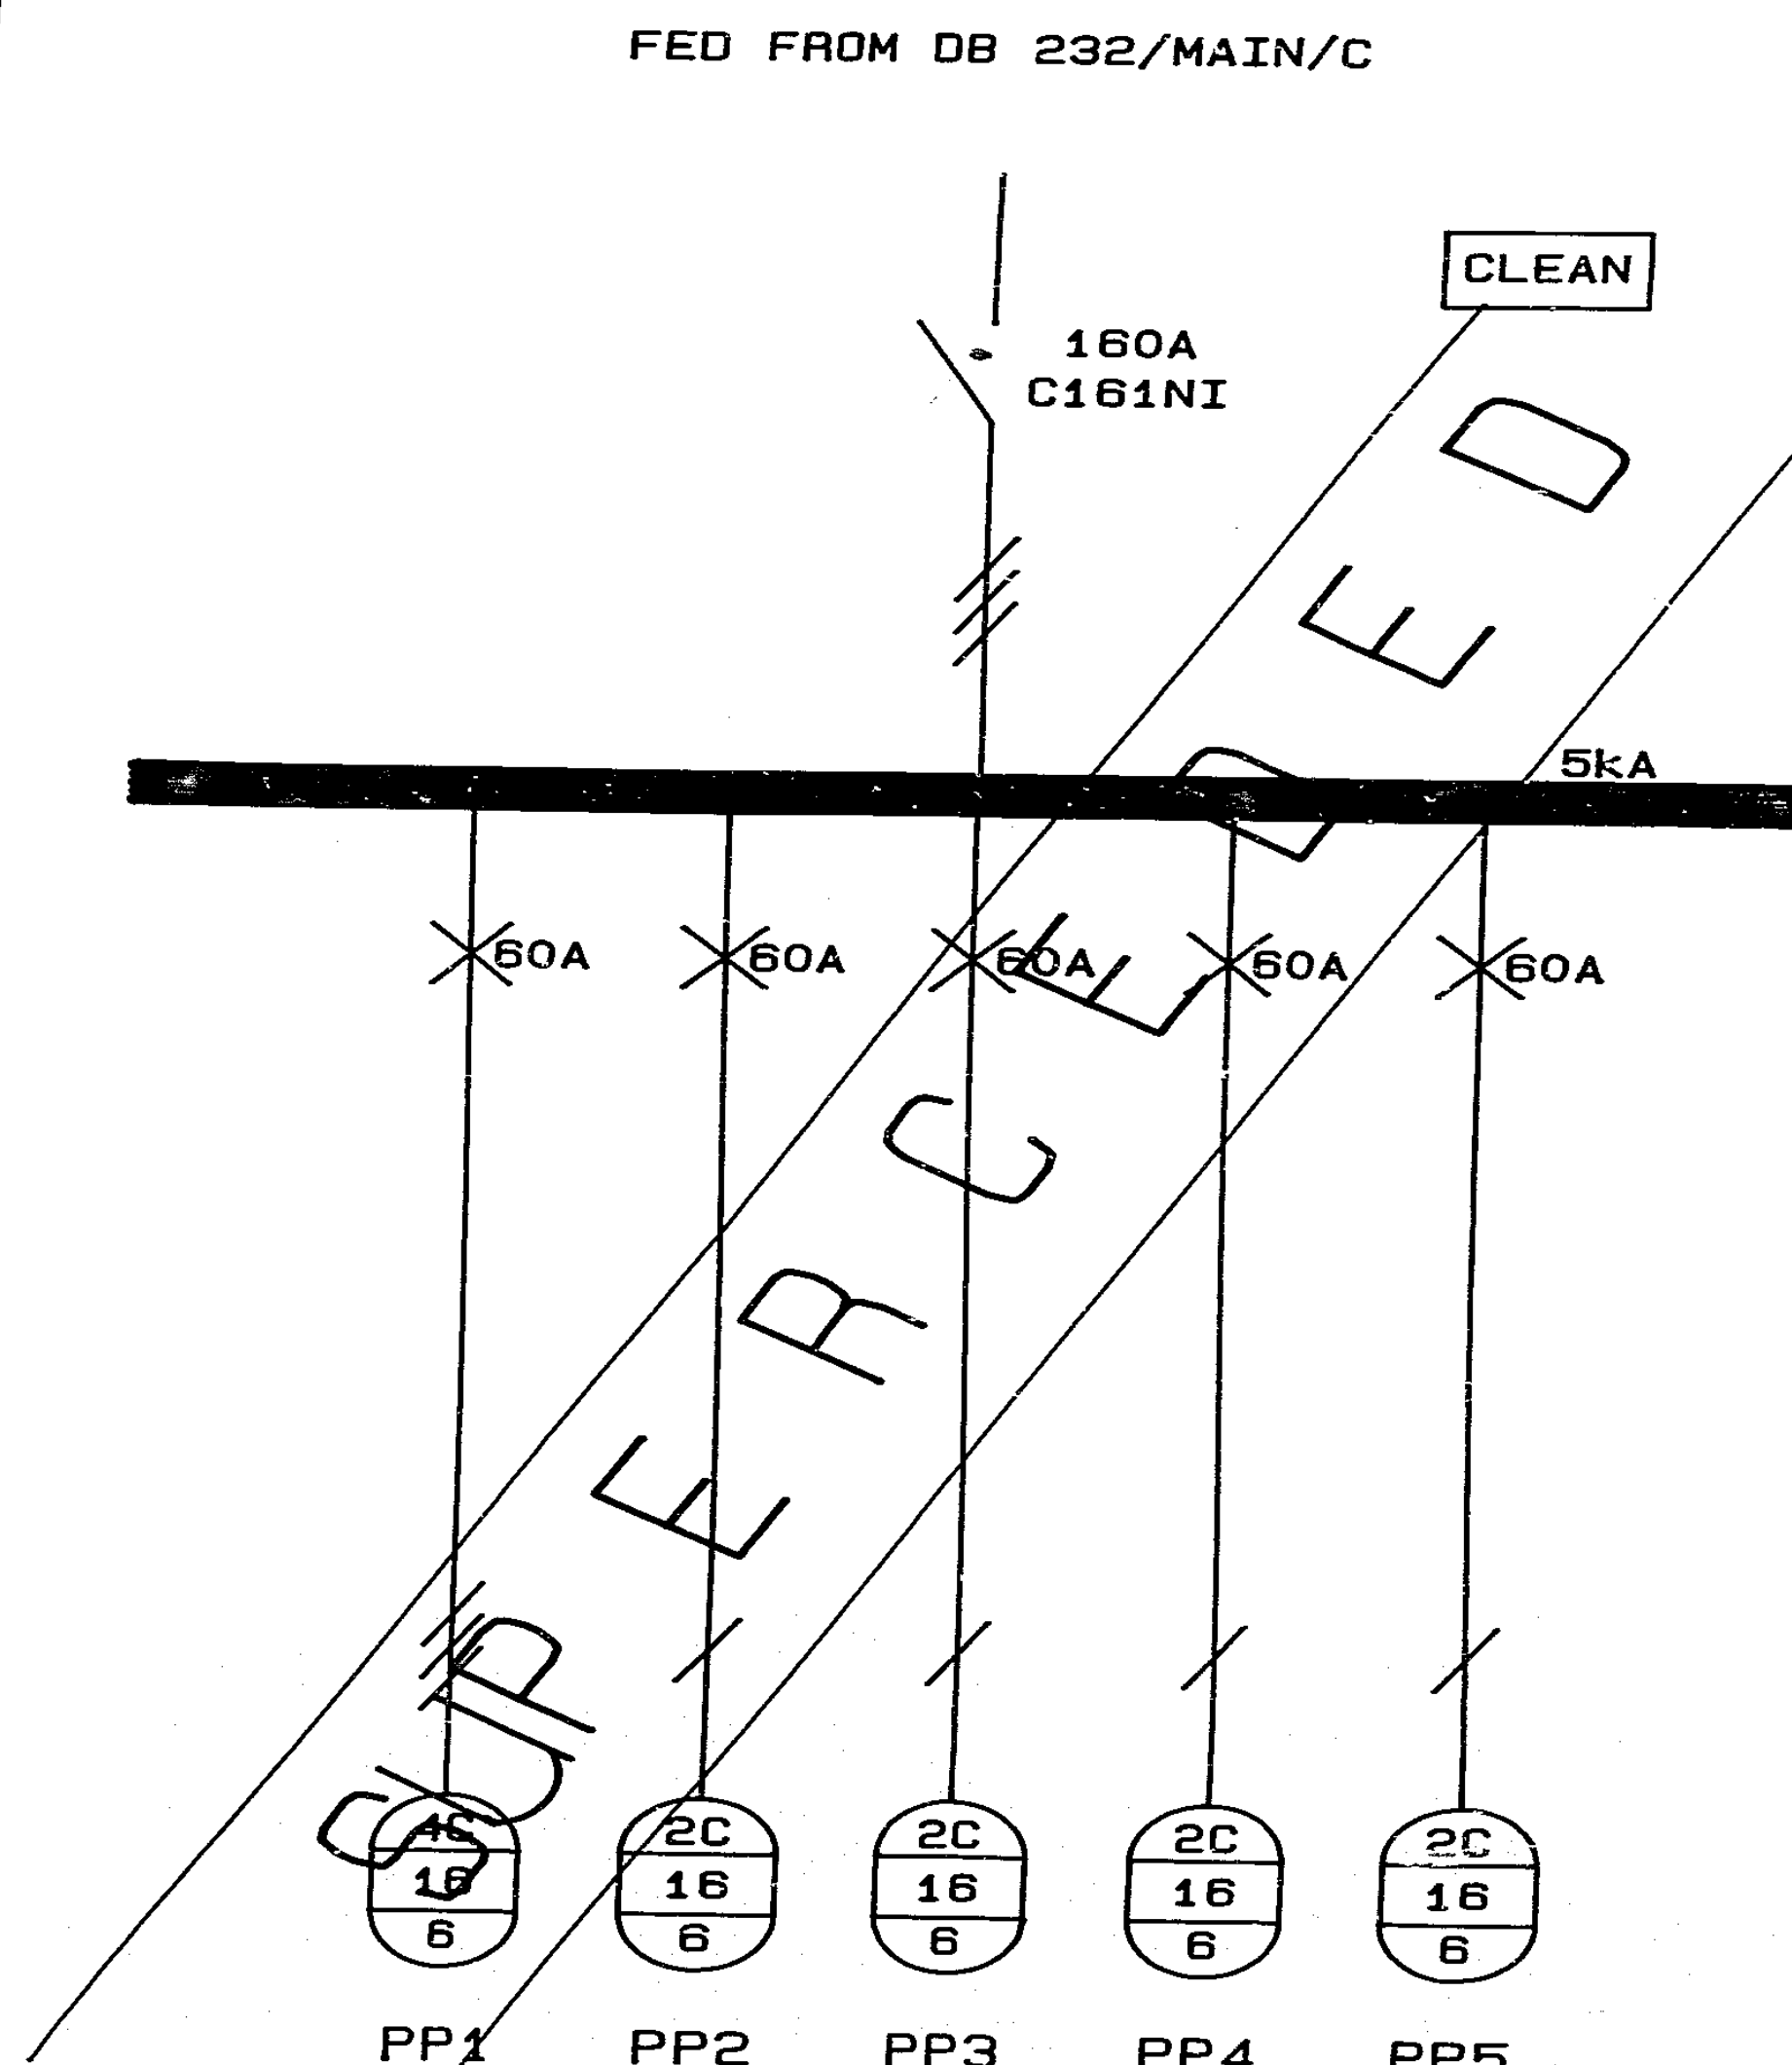

TO EMC ROOM FILTERS

AS BUILT


DISTRIBUTION BOARD CONSTRUCTION

| | | | | | | | |
|----------------|-------------------------------------|--------------------|-------------------------------------|--------------------|-------------------|--------|--|
| RECESSED | <input type="checkbox"/> | LOCKABLE DOORS | <input type="checkbox"/> | COLOUR - MAIN | ELECTRICAL ORANGE | WIDTH | |
| HALF-RECESSED | <input type="checkbox"/> | SEPERATE DIVISIONS | <input type="checkbox"/> | COLOUR - EMERGENCY | | HEIGHT | |
| SURFACE | <input checked="" type="checkbox"/> | EMERGENCY SECTION | <input type="checkbox"/> | COLOUR - UPS | VERDIGRIS GREEN | DEPTH | |
| FLOOR-STANDING | <input type="checkbox"/> | UPS SECTION | <input checked="" type="checkbox"/> | COLOUR - NORMAL | | | |
| DOORS | <input checked="" type="checkbox"/> | NORMAL SECTION | <input type="checkbox"/> | SPARE SPACE | 30 % | | |

DISTRIBUTION BOARD ELECTRICAL SPECIFICATION

| | | | | | |
|----------------|-------------------------------------|---------------------|-------------------------------------|---------------------|-------------------------------------|
| BUSBAR RATING | 5kA | FRONT ACCESS | <input checked="" type="checkbox"/> | CABLE ENTRY: TOP | <input type="checkbox"/> |
| FAULT LEVEL | | REAR ACCESS | <input type="checkbox"/> | CABLE ENTRY: BOTTOM | <input checked="" type="checkbox"/> |
| FULL NEUTRAL | <input checked="" type="checkbox"/> | SUPPLY: SINGLE CORE | <input type="checkbox"/> | FUTURE EXPANSION | <input type="checkbox"/> |
| HALF - NEUTRAL | <input type="checkbox"/> | SUPPLY: CABLE | <input checked="" type="checkbox"/> | CABLE ENTRY: REAR | <input type="checkbox"/> |
| EQUIPMENT | MEALIN GERIN | SUPPLY: BUSBAR | <input checked="" type="checkbox"/> | | |

| NO. | DATE | DESCRIPTION |
|-----|-------|---|
| 1 | 02/91 | ALTERED DB - 400HZ AND NORMAL COMPARTMENT DELETED. DETAIL DRAWING OF PANEL DOES NOT APPLY. CLEAN COMPARTMENT CHANGED. |
| | | |
| | | |
| | | |

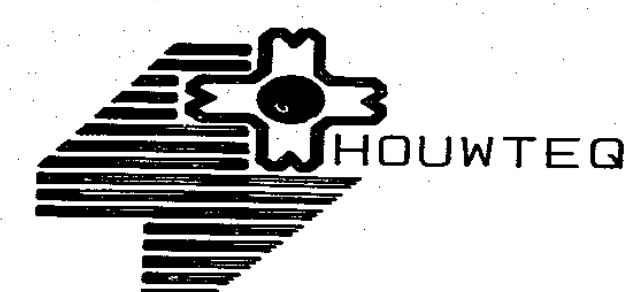

| | | | |
|--------------|---------------------|-------|-----------|
| BKS Inc./Ing | | | |
| CONS. NO. | BKS-4771/232/ZE/052 | REV. | Z |
| DESIGNED | H. P. M. | DRAWN | H. B/CAD |
| CHECKED | H. P. M. | DATE | SEPT 1990 |

| | |
|----------|---|
| TITLE | SCHEMATIC - GROUND FLOOR DB 232/PO/1/C (NORMAL AND CLEAN) |
| DWG. NO. | 671/000 2462 |
| REV. | Z |