



DISTRIBUTION BOARD CONSTRUCTION						DISTRIBUTION BOARD ELECTRICAL SPECIFICATION					
RECESSED		LOCKABLE DOORS	<input checked="" type="checkbox"/>	COLOUR - MAIN	ELECTRIC ORANGE	BUSBAR RATING	60A	FRONT ACCESS	<input checked="" type="checkbox"/>	CABLE ENTRY: TOP	<input checked="" type="checkbox"/>
HALF-RECESSED		SEPERATE DIVISIONS	<input checked="" type="checkbox"/>	COLOUR - EMERGENCY	RED	FAULT LEVEL	5kA	REAR ACCESS	<input checked="" type="checkbox"/>	CABLE ENTRY: BOTTOM	<input checked="" type="checkbox"/>
SURFACE	<input checked="" type="checkbox"/>	EMERGENCY SECTION	<input checked="" type="checkbox"/>	COLOUR - UPS	VERDIGRIS GREEN	FULL NEUTRAL	<input checked="" type="checkbox"/>	SUPPLY: SINGLE CORE	<input checked="" type="checkbox"/>	FUTURE EXPANSION	<input checked="" type="checkbox"/>
FLOOR-STANDING	<input checked="" type="checkbox"/>	UPS SECTION	<input checked="" type="checkbox"/>	COLOUR - NORMAL	ELECTRIC ORANGE	HALF - NEUTRAL	<input checked="" type="checkbox"/>	SUPPLY: CABLE	<input checked="" type="checkbox"/>	CABLE ENTRY: REAR	<input checked="" type="checkbox"/>
DOORS	<input checked="" type="checkbox"/>	NORMAL SECTION	<input checked="" type="checkbox"/>	SPARE SPACE	30%	EQUIPMENT	<input checked="" type="checkbox"/>	SUPPLY: BUSBAR	<input checked="" type="checkbox"/>	FUTURE EXPANSION	<input checked="" type="checkbox"/>

REVISIONS	NO.	DATE	DESCRIPTION


BKS Inc./Ing				TITLE			
CONS. NO. BKS-4771/232/ZE/073				SCHEMATIC - GROUND FLOOR			
DESIGNED H. P. M.				DB 232/AG1/N/E/C			
DRAWN H. B/CAD				671/0002485			
CHECKED H. P. M.				REV. Z			
DATE FEB 1991							

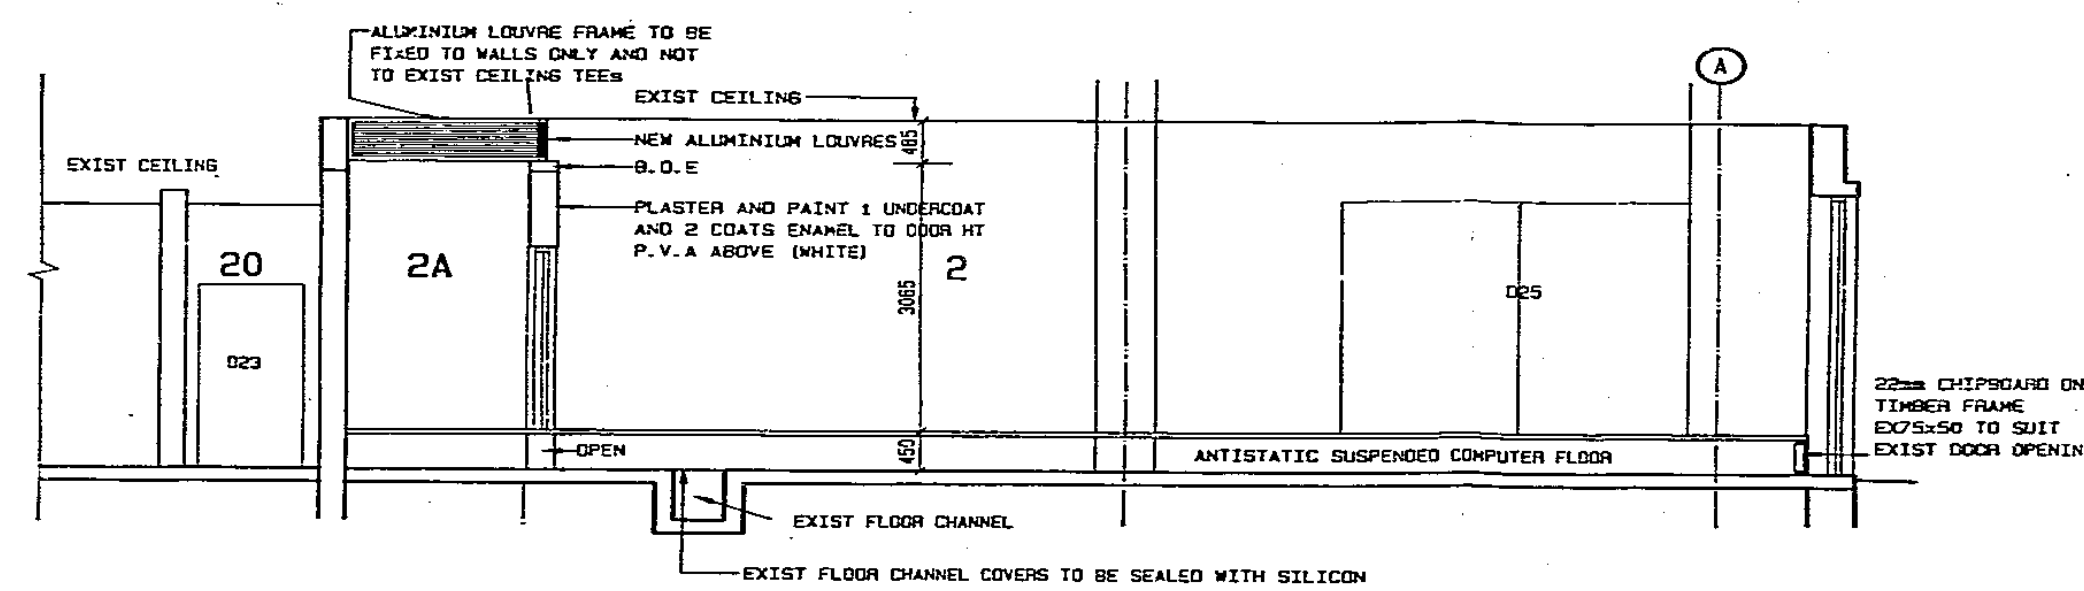


SECTION A-A

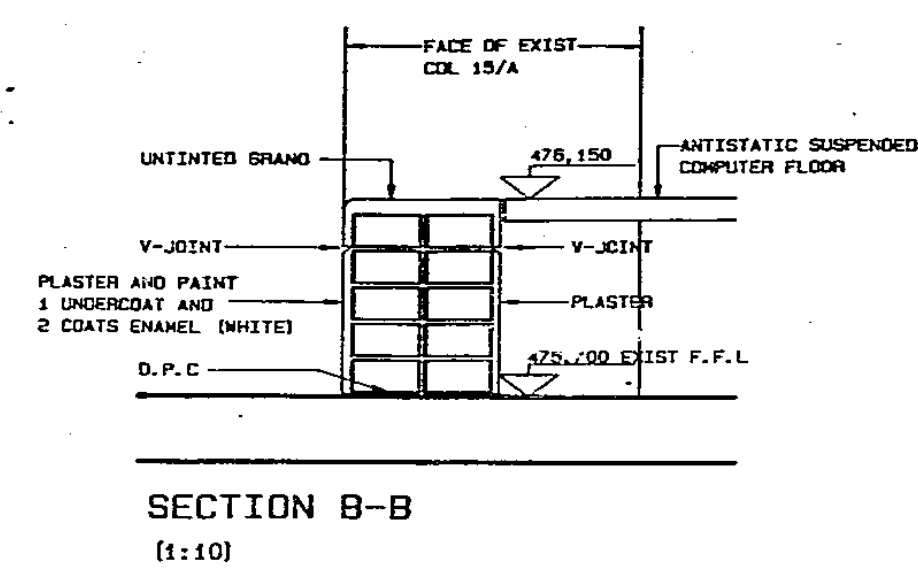


SECTION B-B
(1:10)

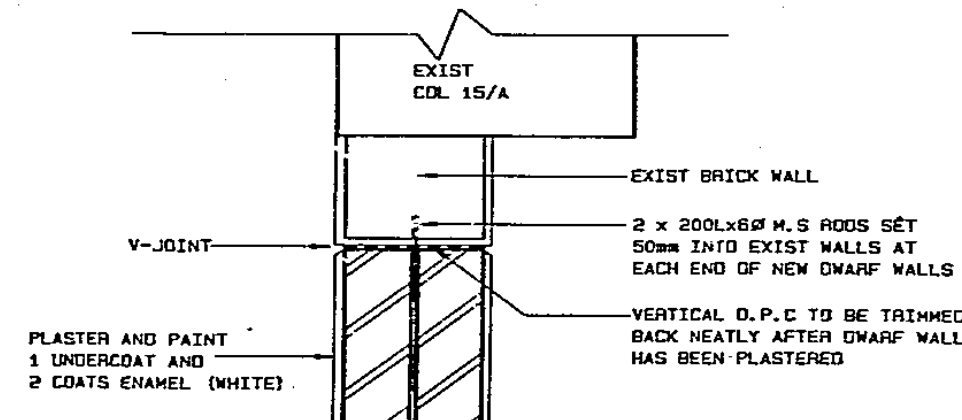

PART PLAN
(1:10)

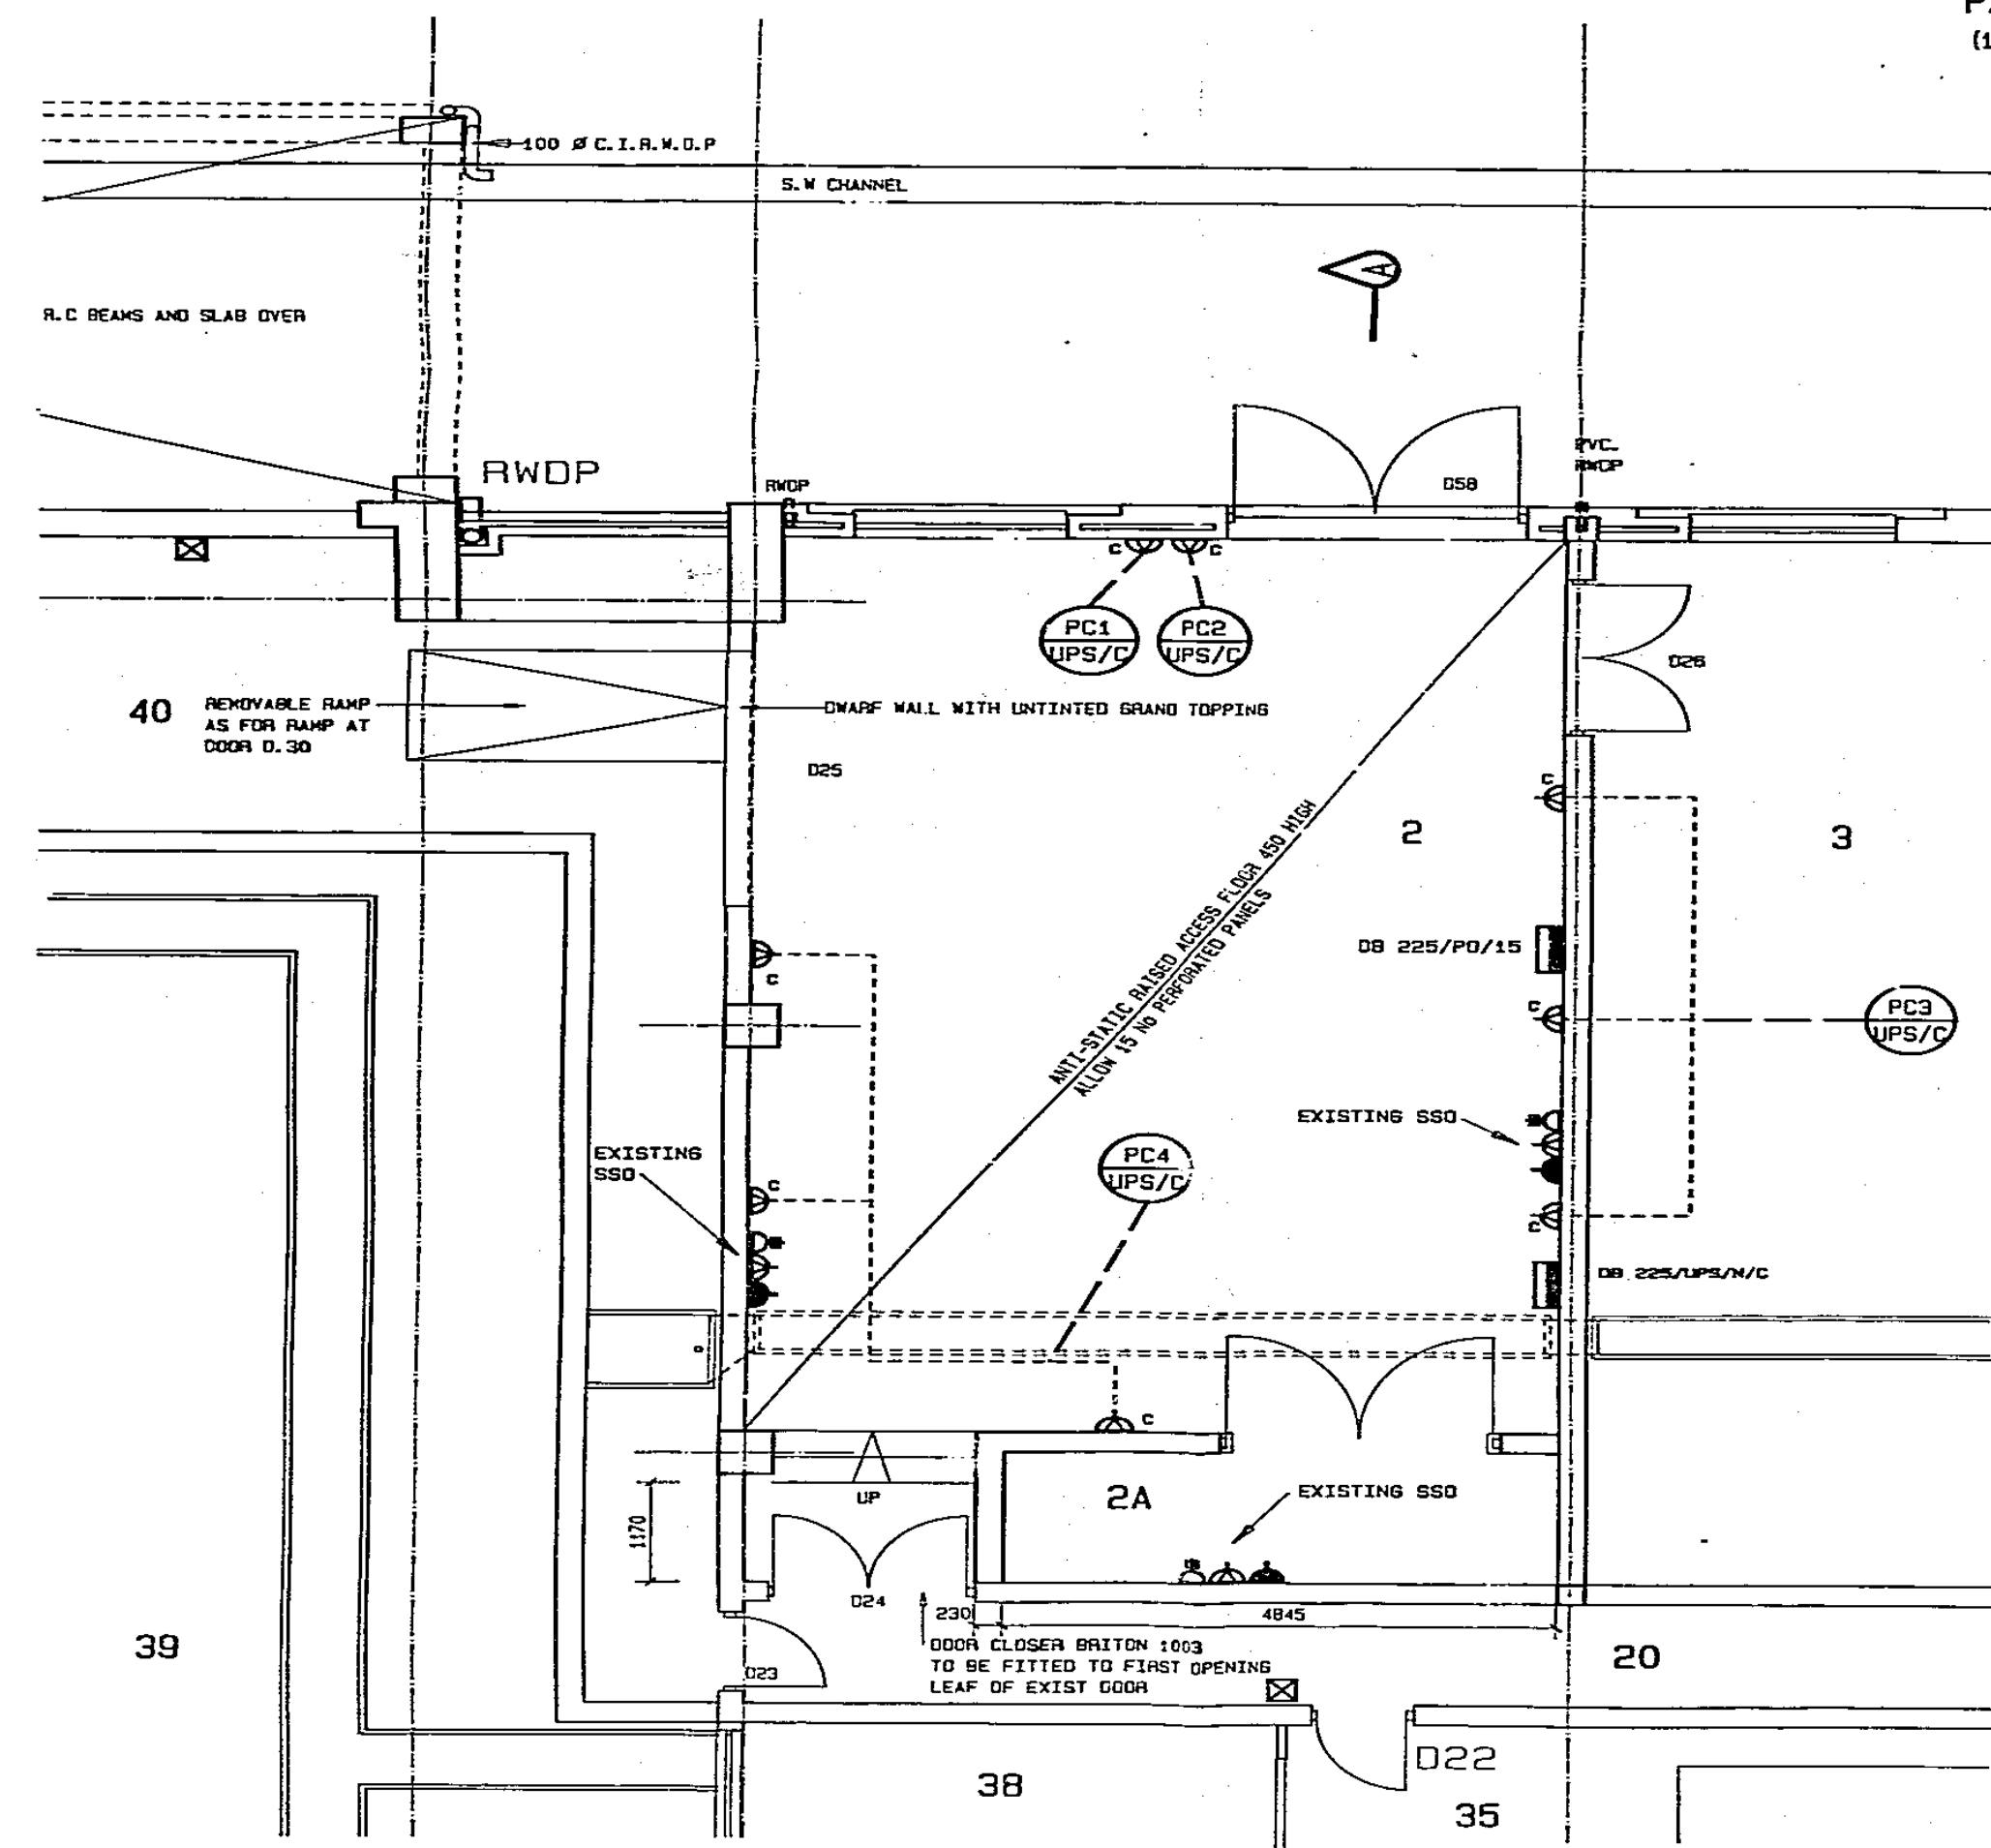


ELECTRICAL LAYOUT ABOVE ANTISTATIC FLOOR

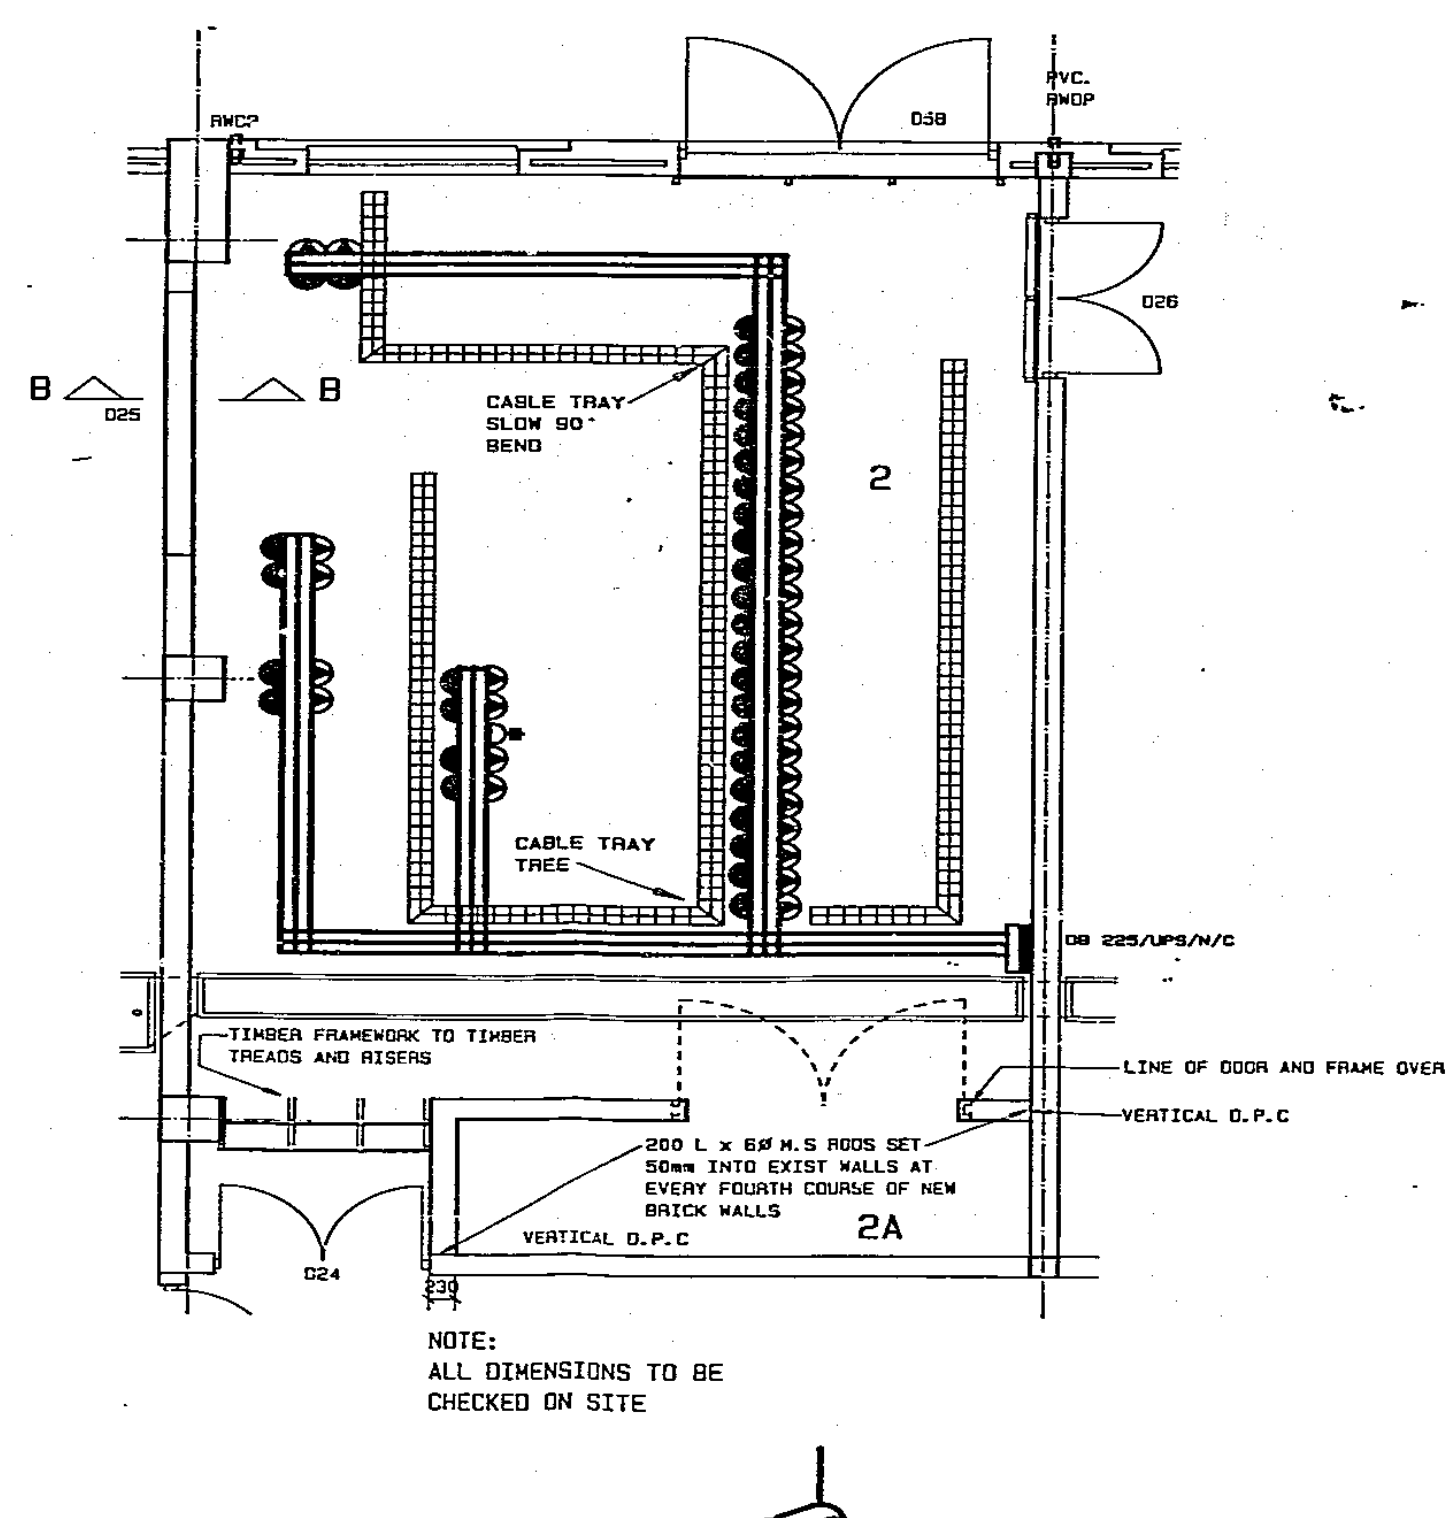

ELECTRICAL LAYOUT ABOVE ANTISTATIC FLOOR

- ELECTRICAL NOTES:**
1. EACH SSO TO BE WIRED ON ONE CIRCUIT UNLESS OTHERWISE INDICATED
 2. CABLE TRAY TO RUN ABOVE VOID DUCT
 3. ALL SSC TO BE LABELLED WITH RELEVANT CIRCUIT NUMBER
 4. DISTRIBUTION BOARD TO BE MOUNTED 1500mm ABOVE ANTI-STATIC FLOOR TO BOTTOM OF DB

- ELECTRICAL LEGEND**
- 2 COMPARTMENT VOID DUCT
 - 200mm WIDE CABLE TRAY
 - SURFACE MOUNTED DISTRIBUTION BOARD
 - FLUSH VOID DUCT MOUNTED CLEAN SSO (BLACK)
 - FLUSH VOID DUCT MOUNTED NORMAL SSO
 - SURFACE MOUNTED CLEAN SSO IN 4x4 WOODEN BOX (BLACK) 1500mm ABOVE ANTI-STATIC FLOOR

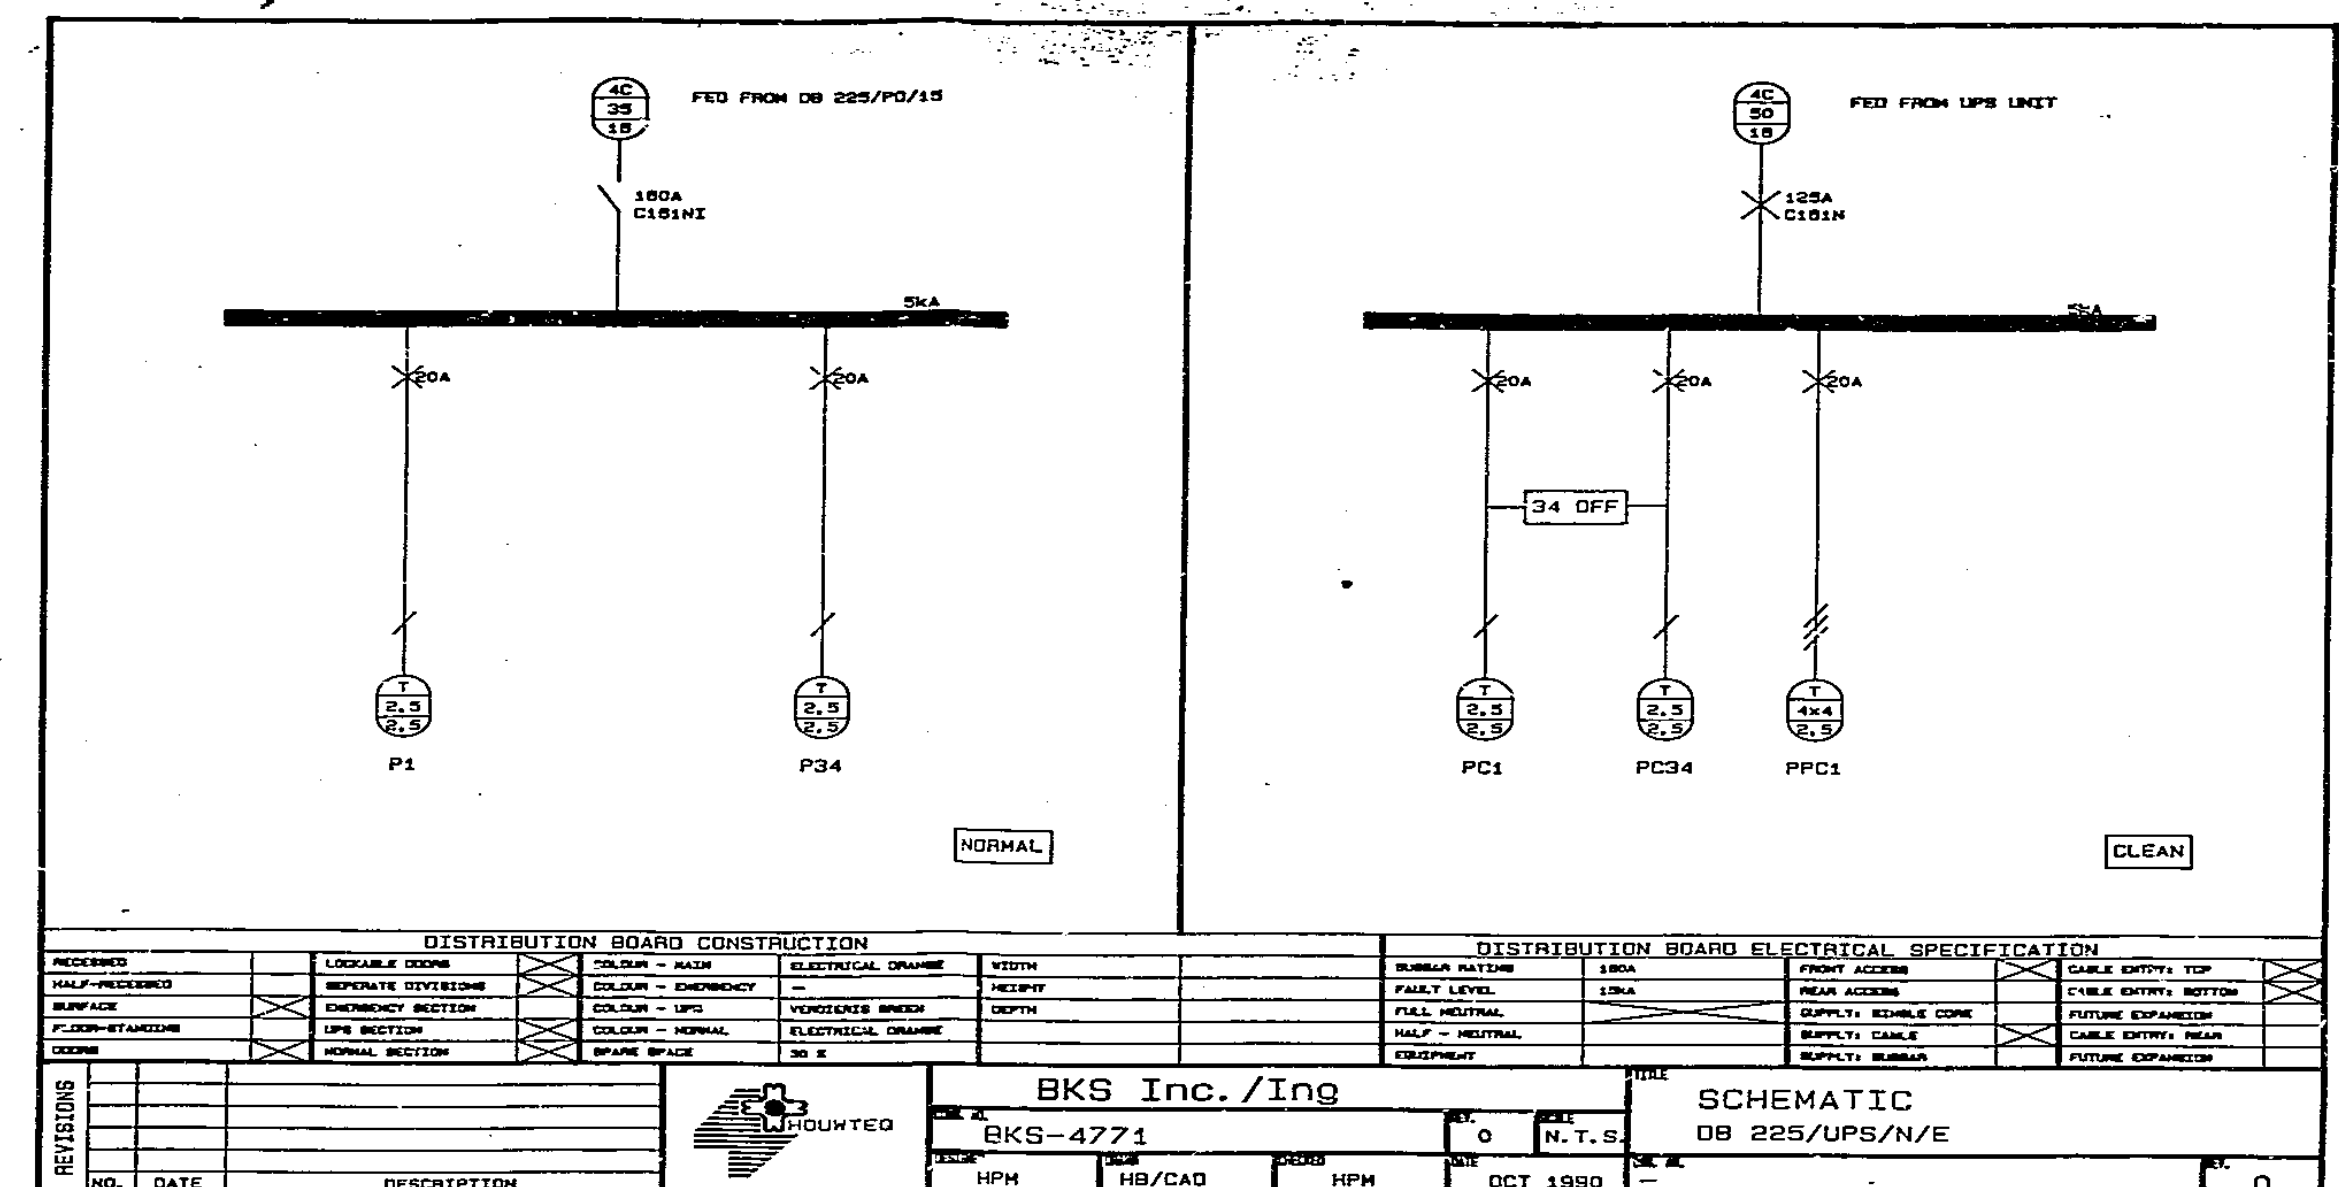

DISTRIBUTION BOARD CONSTRUCTION

DISTRIBUTION BOARD ELECTRICAL SPECIFICATION

BKS Inc./Ing

BKS-4774

SCHEMATIC DB 225/UPS/N/E

NO. DATE DESCRIPTION

HPM HB/CAD HPM HPB

OCT 1990

0

AS BUILT

671/000 2483 Z

671/000 2483 Z

