





USED ON	N.H.ASSY
VTFM-00000	VTFM-00000



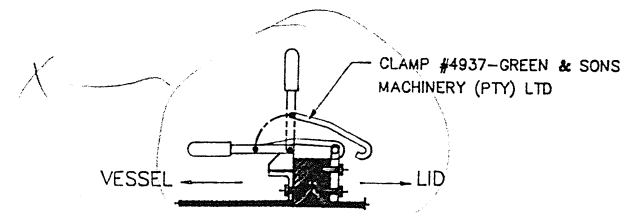

SIDE VIEW OF LID CLAMPING MECHANISM
TYPICAL 4 PLACES SPACED @ 90°

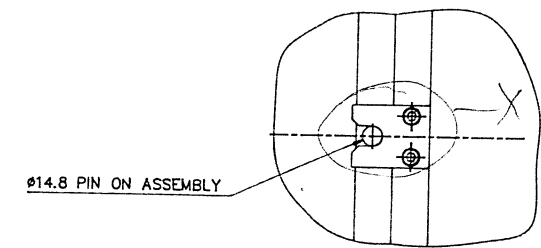

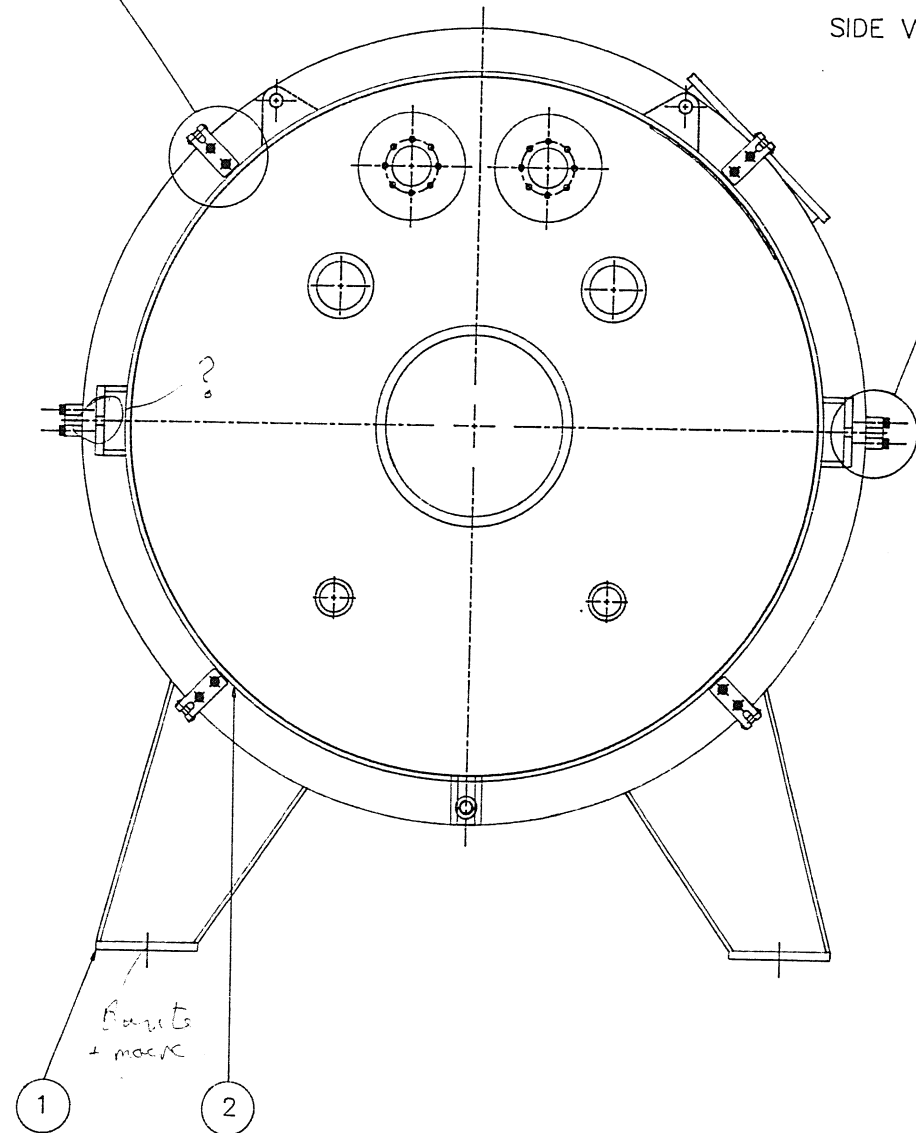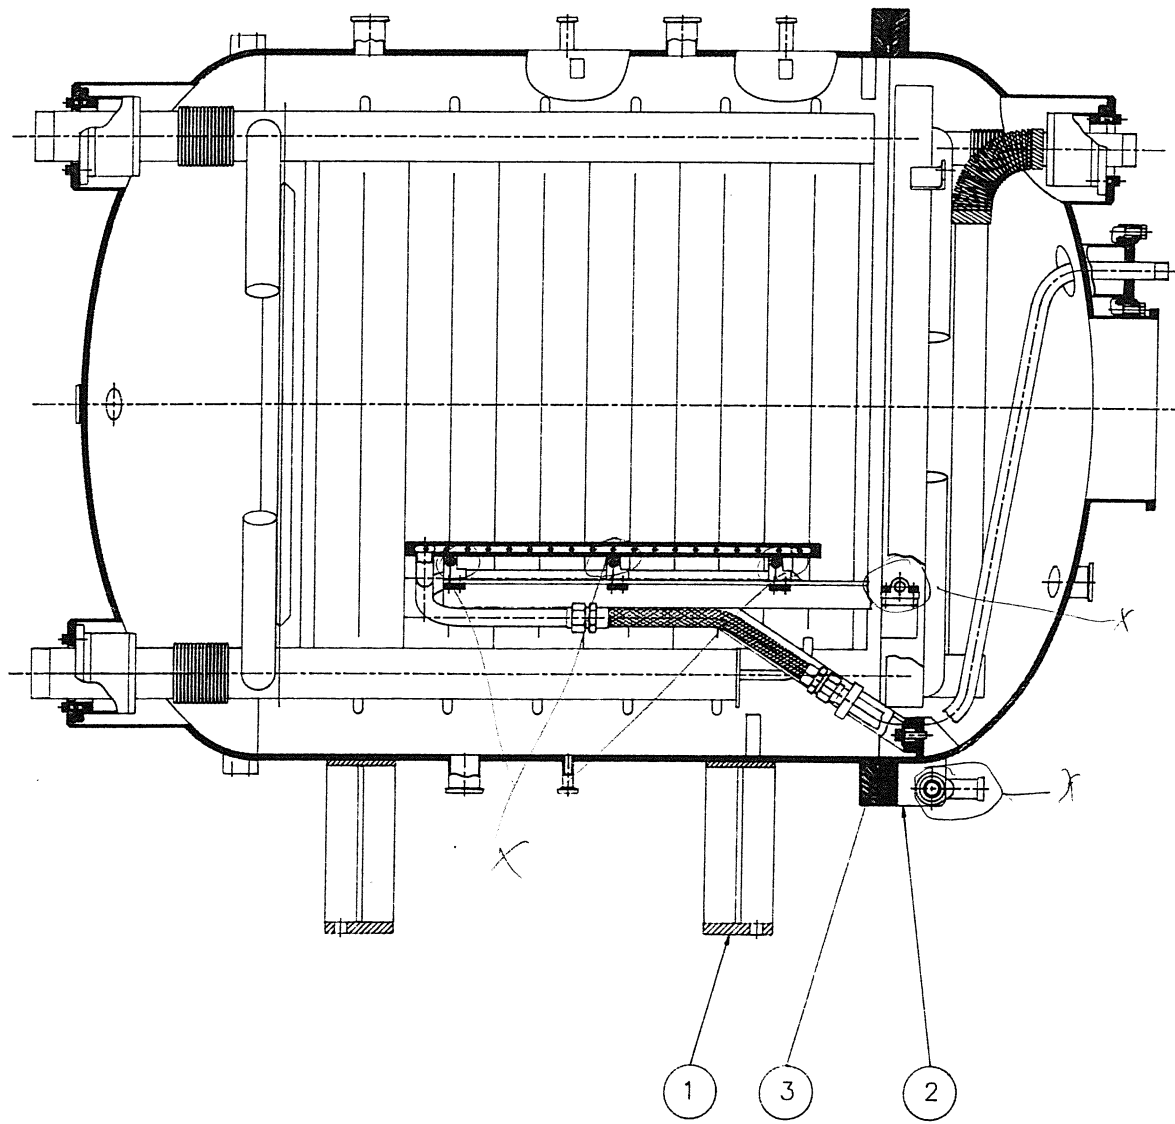SIDE VIEW OF CENTER GUIDE
SCALE 1:2.5



DRAWING STATUS	ACTIVE	SIGN:	DATE:
FOR 3rd. PARTY APPROVAL			
PERMIT MATERIAL ORDER			
FOR MANUFACTURE			
AS BUILT			
SUPERSEDED			

														TITLE : TEST CHAMBER																									
										TO SABS 0111				ISSUE		A																							
										A		-		WB						92-03-17		DISC NO/FILE NAME		DRG NO : VTFM-10000-03										SHT 1 OF 1					
REVISION DETAILS										ISS		C/NOTE		DRAWN		CHECK		APPR		P.OFF.		DATE		VTFM-02A		SCALE : 1:5										WHEN PLOTTED ON UNLESS OTHERWISE STATED		A1	