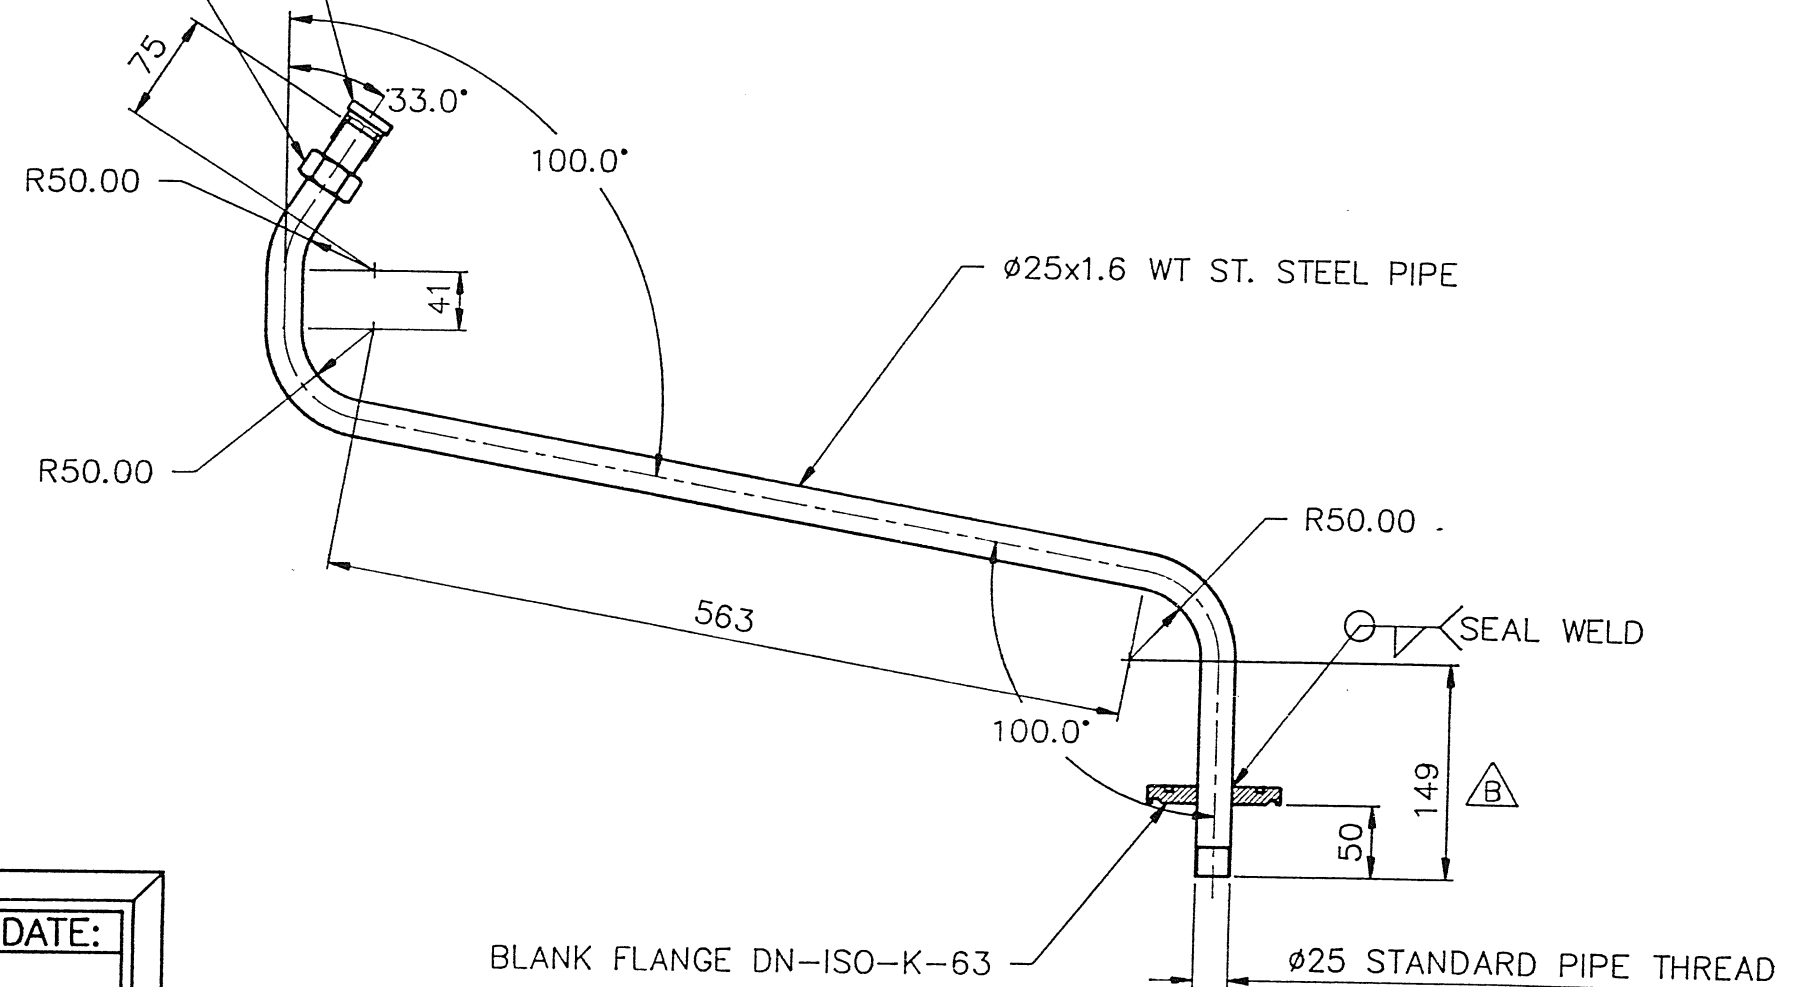


USED ON

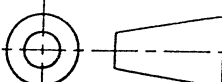

N.H.ASSY

SOCKET WELD GLAND SS-16-VCO-3 (CAJON)

FEMALE NUT SS-16-VCO-4 (CAJON)



IST	DRAWING STATUS	ACTIVE:	SIGN:	DATE:
INFORMATION ONLY				
FOR 3rd. PARTY APPROVAL				
PERMIT MATERIAL ORDER				
FOR MANUFACTURE				
AS BUILT				
SUPERSEDED				

											TITLE : CONNECTOR PIPE												
125 — 149	B	—	WB				92-05-21	TO SABS 0111	ISSUE		A	B											
	A	—	WB				92-03-11	DISC NO/FILE NAME	DRG NO : VTFM-12500-122 SHT 1 OF 1														
REVISION DETAILS	ISS	C/NOTE	DRAWN	CHECK	APPR	P.OFF.	DATE	VTFM-17B	SCALE : 1:5 WHEN PLOTTED ON A3 UNLESS OTHERWISE STATED														