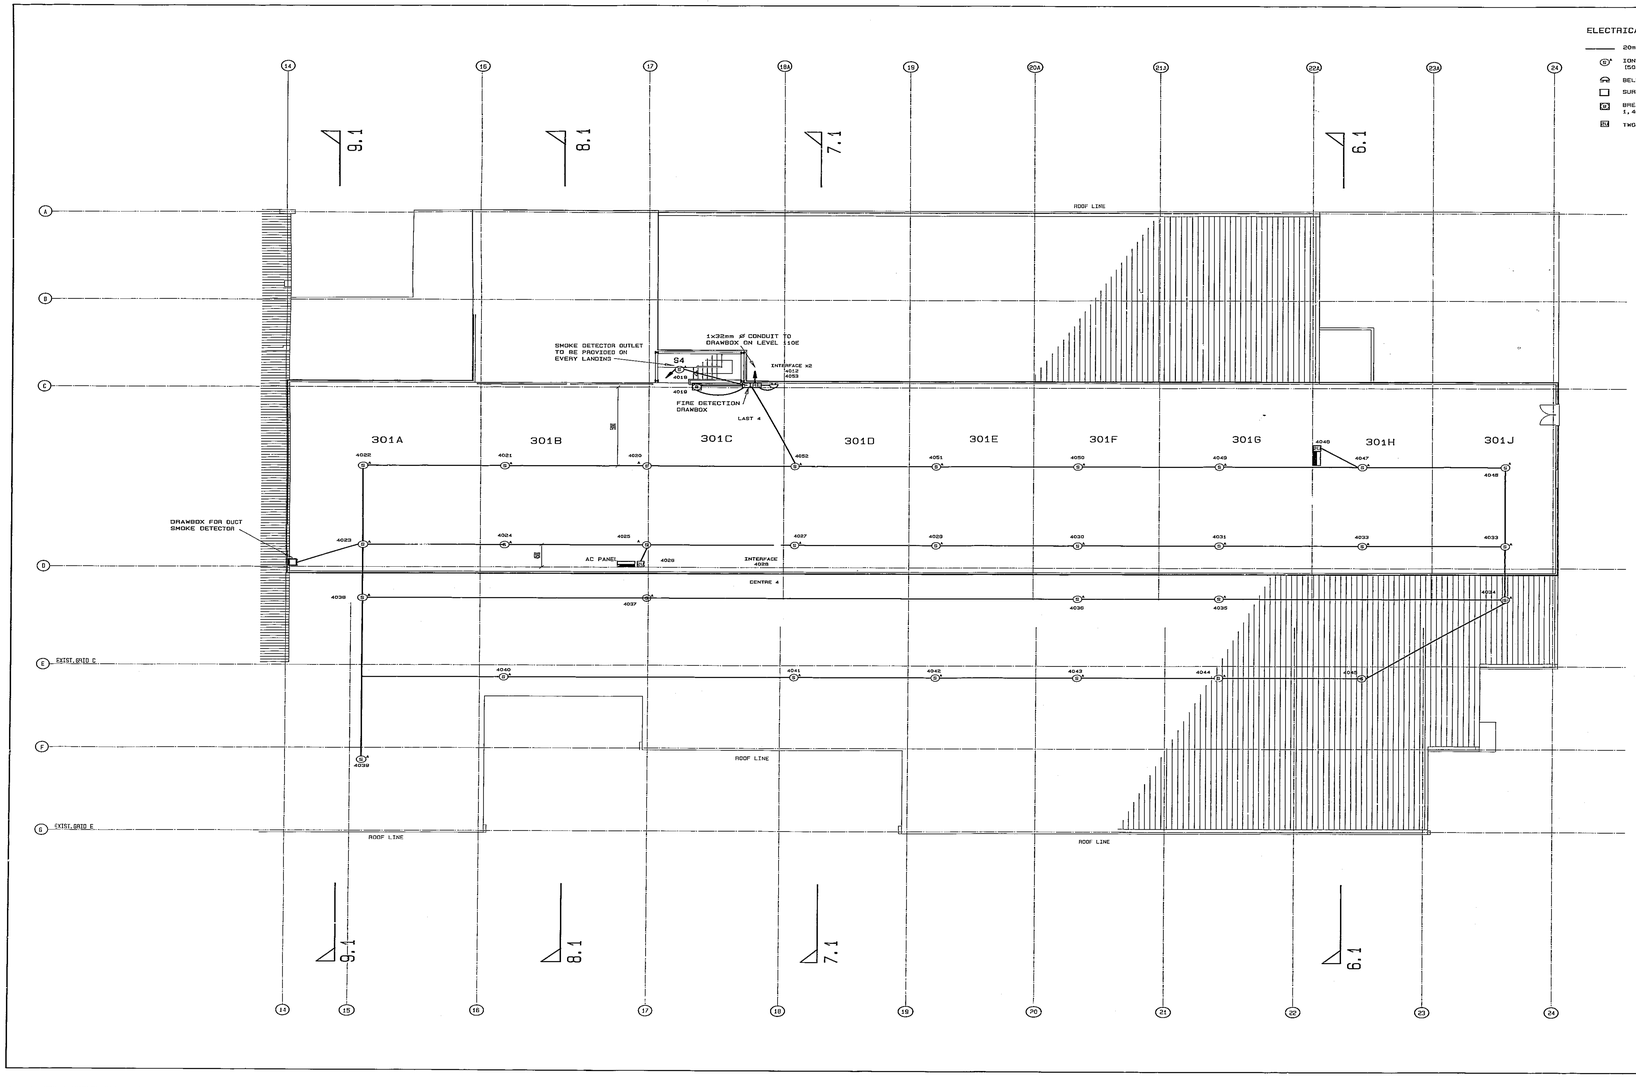


## ELECTRICAL LEGEND

- 20mm ø CONDUIT UNLESS OTHERWISE SPECIFIED
- IONIZATION TYPE SMOKE DETECTOR-TRUSS MOUNTED (50mm ø ROUND BOX)
- BELL (100x50x50 OUTLET BOX)
- SURFACE MOUNTED DRAWBOX - 100x100x50mm
- BREAK GLASS RELEASE (100x50x50 OUTLET BOX - HEIGHT: 1,4m AFFL)
- TWO OUTPUTS (4x4 BOX)

AS BUILT

notes

COPYRIGHT IS RESERVED ON THIS DRAWING

| rev. | date | by | mod. | description |
|---|---|---|---|---|
| 00 | | | | |
| 01 | FEB 01 | HPM | SV | CONSTRUCTION DRAWING, ADMIN AC PANEL OUTPUTS |
| 02 | | | | |
| 03 | | | | |
| 04 | | | | |
| 05 | | | | |
| 06 | | | | |
| 07 | | | | |
| 08 | | | | |

legend site a

legend site b

C. A. D | disc no. | file name: BLDG32P4

| LAYER | DESCRIPTION | PLOTTED | | |
|---|---|---|---|---|
| 1 | STRUCTURE | | | |
| 2 | FLOOR DUCTS | | | |
| 3 | RELOCATION | | | |
| 4 | DOORS & WINDOWS | | | |
| 5 | FITTINGS & FIXTURES | | | |
| 6 | NOTES & RELATED TEXT | | | |
| 7 | TEXT & PATTERN LINES | | | |
| 8 | DIMENSIONS | | | |
| 9 | | | | |
| 10 | CEILING GRID | | | |
| 11 | | | | |
| 12 | | | | |
| 13 | SEWER | | | |
| 14 | STORMWATER | | | |
| 15 | | | | |

system | operator | date | revision

CONSULTANTS

BKS INK/INC CONSULTING ENGINEERS (011) 7481570

JEFFARES,VAN HOEKDYK & PARTNERS INC. CONSULTING ENGINEERS (011) 7826430 (011) 4885040

MILPARK, VAN DER LEDE, THOMAS & ROWA (011) 2440500

VAN NIEKERK,KLEYN & EDWARDS CONSULTING ENGINEERS (011) 326244

HOUWTEQ

HAASVLAKTE

| for comment | date | for tender | date |
|---|---|---|---|

title

# BUILDING 232
## SITE A

drawing title

## SERVICE FLOOR FIRE DETECTION LAYOUT

| contract no. | contr. drg. no. | contr. rev. |
|---|---|---|
| P4771 | P4771/232/2E/01B | Z |
| drawn | checked | date | scale |
| HB/CAD | HPM | AUG 1990 | 1:100 |
| houwteq drg. no. | | | revision |
| 671/0002428 | | | Z |