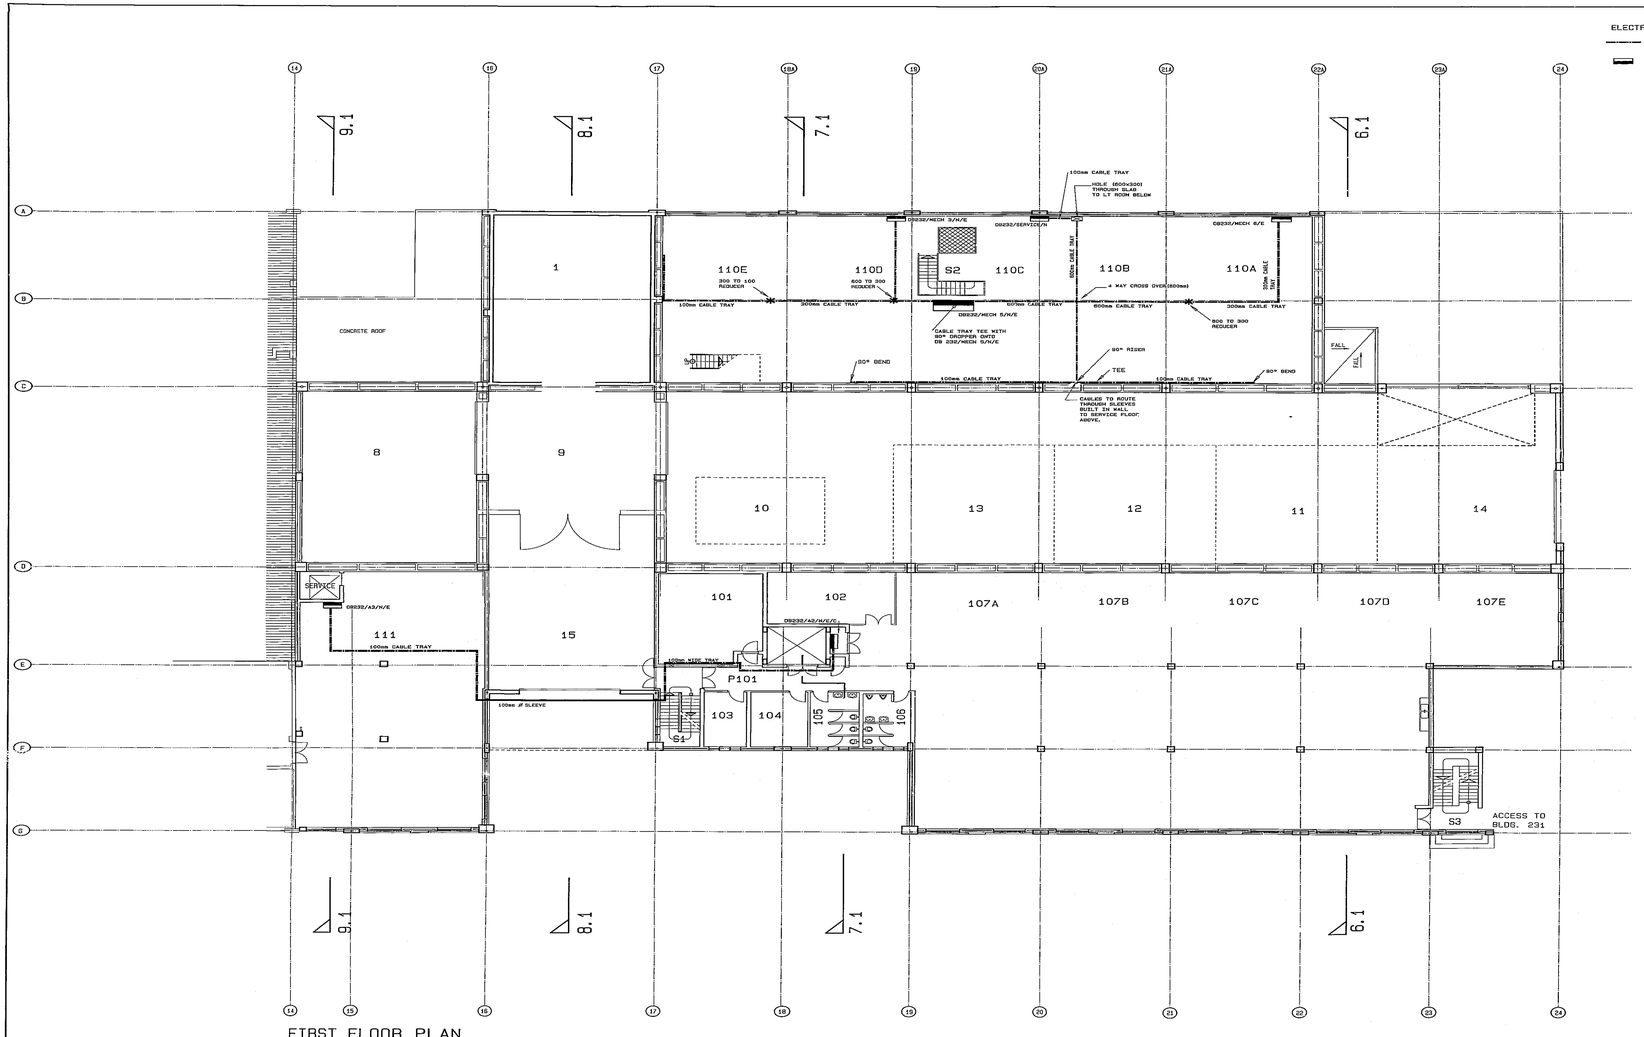

AS BUILT

notes

COPYRIGHT IS RESERVED ON THIS DRAWING

rev.	date	by	auth.	
00				
01	90/09/20	HPM	BN	REVISED CABLE TRAY ROUTE
02				
03				
04				
05				
06				
07				
08				
09				

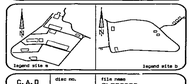

C. A. D | drawn no.

file name: BLDG232P2

layer	description	plotted		
1	STRUCTURE			
2	FLOOR SHETS			
3	BRICKWORK			
4	DOORS & WINDOWS			
5	FITTINGS & FITTINGS			
7	GRIDS & RELATED TEXT			
7	TEXT & DETTEM LINES			
8	DIMENSIONS			
9				
10	CEILING GRID			
11				
12				
13	DOORS			
14	STORMWATER			
15				

system | operator | date | revision

CONSULTANTS

BAE SMUTS(PE) CONSULTING ENGINEERS (011) 8461070

JEFFARES, VAN HOEVEN & PARTNERS INC. CONSULTING ENGINEERS (011) 7605493 (011) 8854690

MEIRING,VAN DER LEEG, THOMAS & JOUBA ARCHITECTS (011) 342205

VAN HOEVEN, KLEYN & EDWARDS CONSULTING ENGINEERS (011) 336765

GROUTEG

HAASVLAKTE

for consultant | date | for township | date

title

BUILDING 232
SITE A

drawing title

FIRST FLOOR
CABLE TRAY LAYOUT

consultant no.	consultant drawing no.	consultant rev.
P4771	P4771/232/ZE/020	Z
drawn	checked	date	scale
HW/CAD	HPM	AUG 1990	1:100
township drawing no.			revision
671/0002430			Z