USED ON	N.H.ASSY

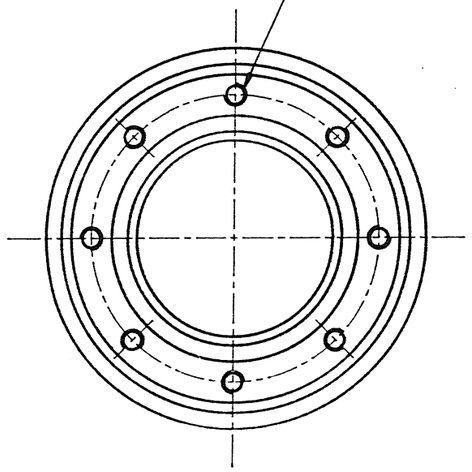

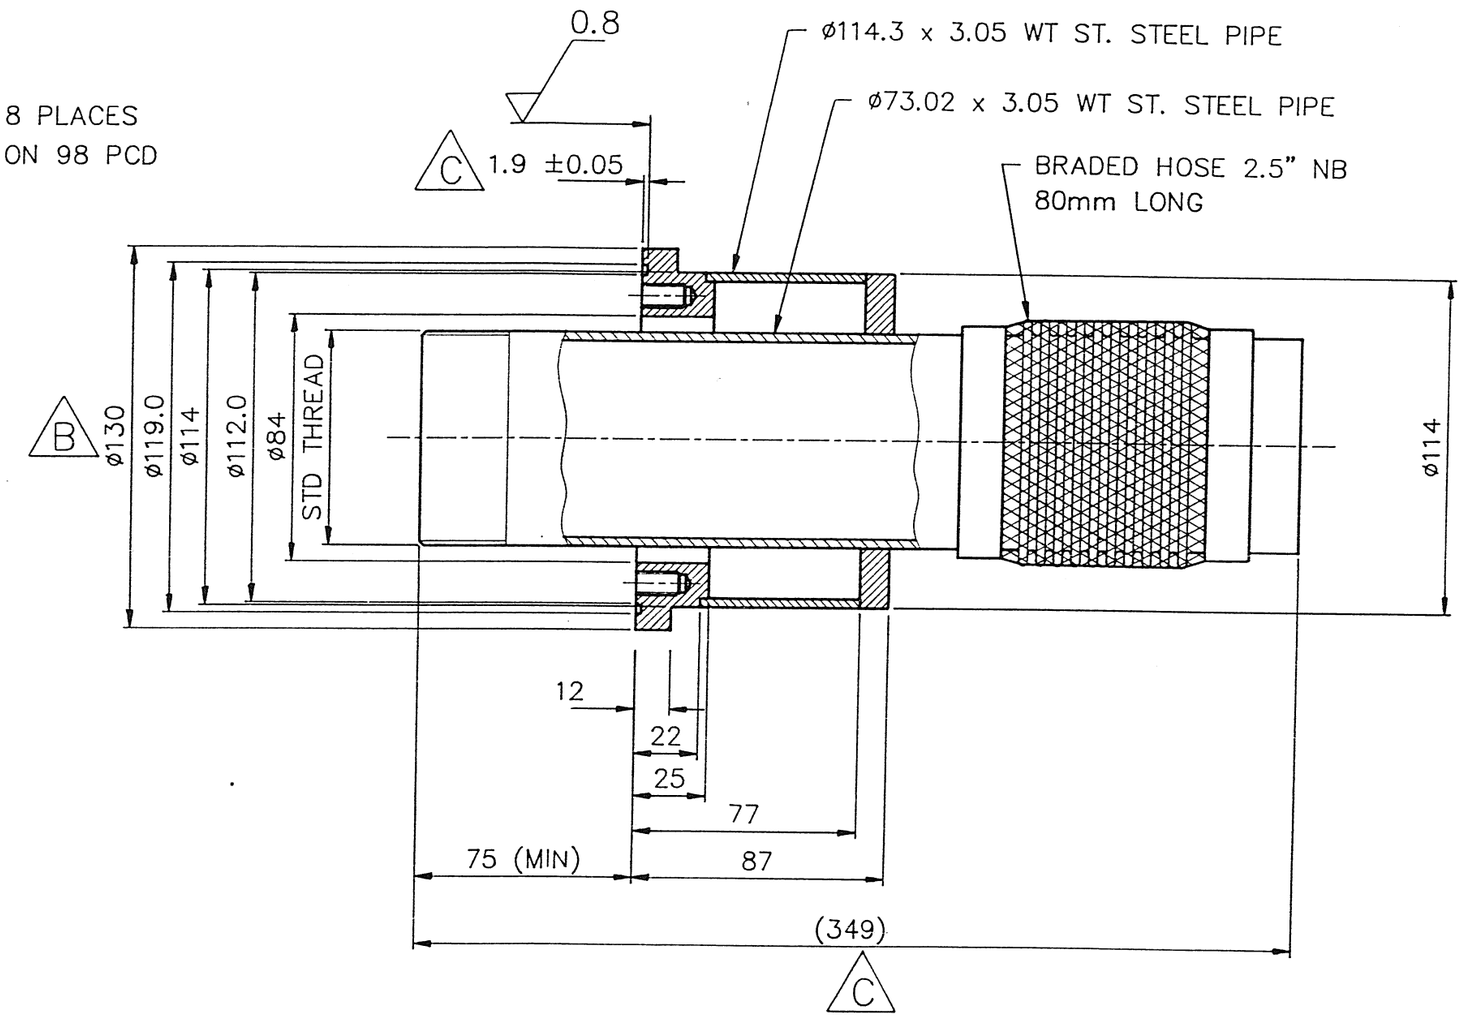

DRAWING STATUS	ACTIVE:	SIGN:	DATE:
INFORMATION ONLY			
FOR 3rd. PARTY APPROVAL			
PERMIT MATERIAL ORDER			
FOR MANUFACTURE			
AS BUILT			
SUPERSEDED			

REVISION DETAILS	ISS	C/NOTE	DRAWN	CHECK	APPR	P.OFF.	DATE
(300) – (349); 1.85 – 1.9 ±0.05	C	–	WB				92–05–20
FLANGE REDESIGN	B	–	WB				92–03–23
	A	–	WB				92–02–20

TO SABS 0111

DISC NO/FILE NAME

VTFM–09C

IST

TITLE : SHROUD VESSEL

ISSUE | A | B | C

DRG NO : VTFM–11200–122 SHT 2 OF 2

SCALE : 1:2

WHEN PLOTTED ON UNLESS OTHERWISE STATED A3