USED ON	N.H.ASSY

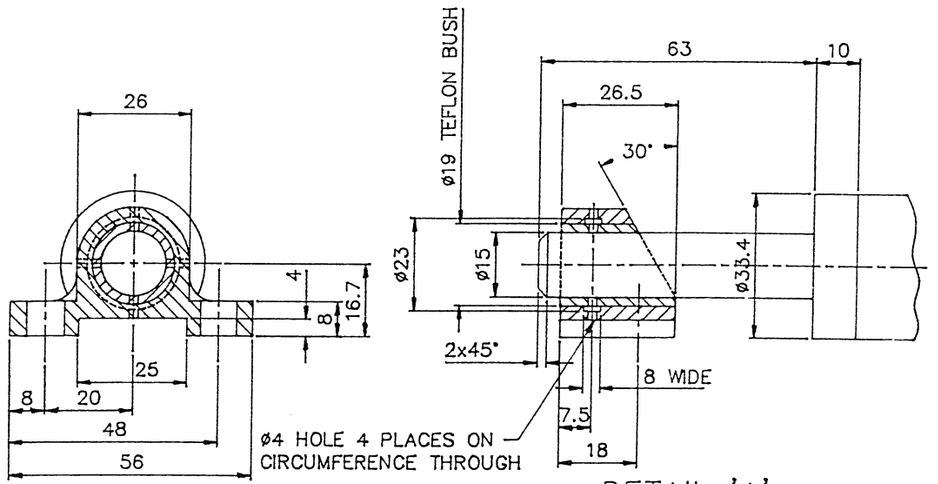

DETAIL 'A'

SCALE 1:1

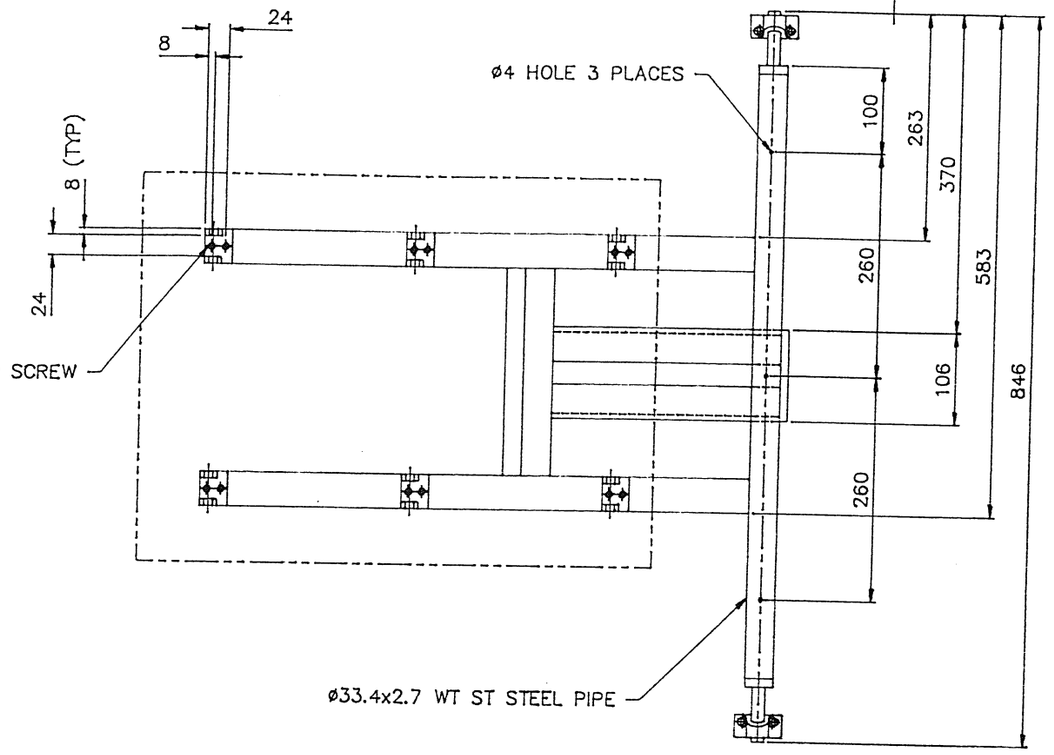

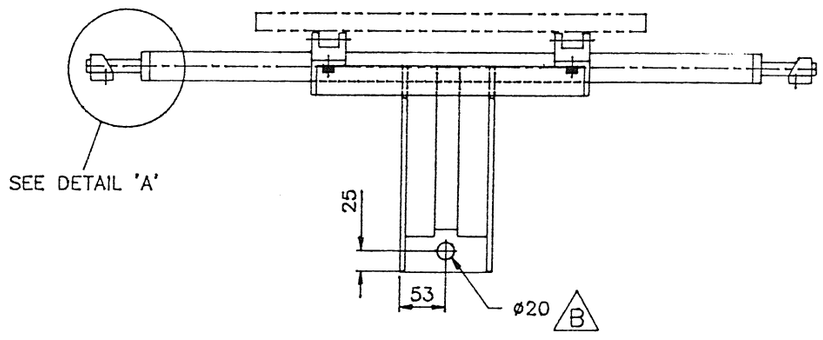

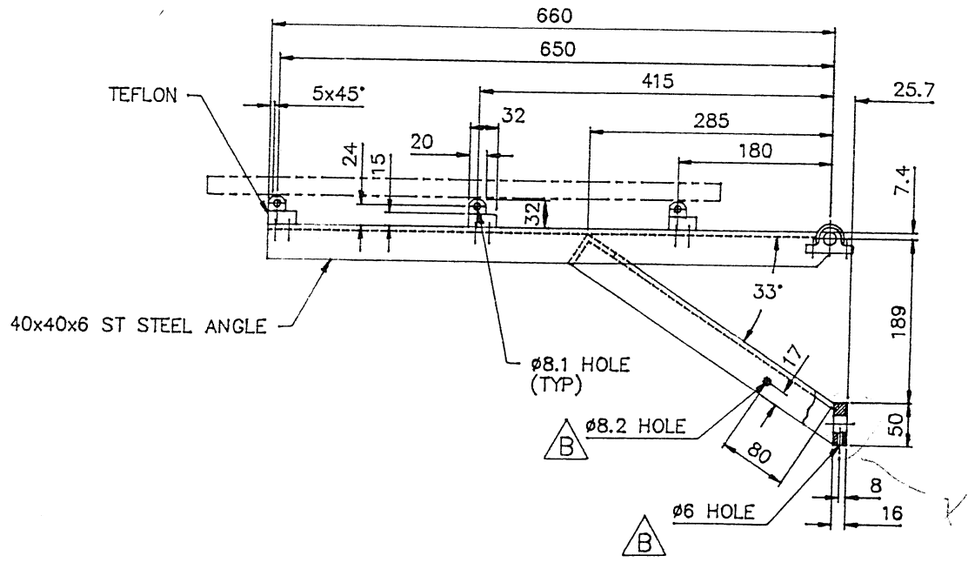

DRAWING STATUS	ACTIVE:	SIGN:	DATE:
INFORMATION ONLY			
FOR 3rd. PARTY APPROVAL			
PERMIT MATERIAL ORDER			
FOR MANUFACTURE			
AS BUILT			
SUPERSEDED			

REVISION DETAILS	ISS	C/NOTE	DRAWN	CHECK	APPR	P.OFF.	DATE
ø10.5–ø20, ø6 +; ø8.2 +	B	–	WB				92–03–18
	A	–	WB				92–02–27

TO SABS 0111

DISC NO/FILE NAME VTFM–12B

TITLE : SUPPORT FRAME

ISSUE A B

DRG NO : VTFM–12300–122 SHT 1 OF 1

SCALE : 1:5

WHEN PLOTTED ON UNLESS OTHERWISE STATED A2